

125146

WELL CONSTRUCTION RECORD

WELL CONTRACTOR: Dewey Wright Well Pump Co., Inc.
 WELL CONTRACTOR CERTIFICATION #: 2687
 STATE WELL CONSTRUCTION PERMIT#: Steve Reece

010049

1. WELL USE (Check Applicable Box): Residential Municipal Industrial Agricultural Monitoring
 Recovery Heat Pump Water Injection Other If Other, List Use: _____

2. WELL LOCATION: (Show sketch of the location below)
 Nearest Town: NEWLAND County: AVERY
GILPIN LANE OFF SQUIRELL CRK OFF SPANISH OAK O
(Road Name and Numbers, Community, or Subdivision and Lot No.)

3. DRILLING LOG

From	To	Formation Description
0	38	DIRT
38	50	GRANITE
50	54	SHALE
54	165	GRANITE

4. DATE DRILLED 1/24/2001

5. TOTAL DEPTH 165

6. CUTTINGS COLLECTED YES NO

7. DOES WELL REPLACE EXISTING WELL? YES NO

8. STATIC WATER LEVEL Below Top of Casing: 20 FT.
(Use "+" if Above Top of Casing)

9. TOP OF CASING IS 1 FT. Above Land Surface*
*Top of casing terminated at/or below land surface requires a variance in accordance with 15A NCAC 2C.0118

10. YIELD (gpm): 5 METHOD OF TEST Air

11. WATER ZONES (depth): 5 gpm 50-54 0 gpm
0 gpm 0 gpm

12. CHLORINATION: Type HTH Amount 30

DEPTH

FORMATION DESCRIPTION

01 FEB - 5 PM 1:57

DIVISION OF WATER SECTION


RECEIVED/LEAD

If additional space is needed use back of form

13. CASING:

From	To	Depth	Diameter	Wall Thickness or Weight/Ft.	Material
0	41 Ft.		8 1/4	188	GALV.
41	_____	_____	_____	_____	_____
_____	_____	_____	_____	_____	_____

LOCATION SKETCH
 (Show direction and distance from at least two State Roads, or other map reference points)

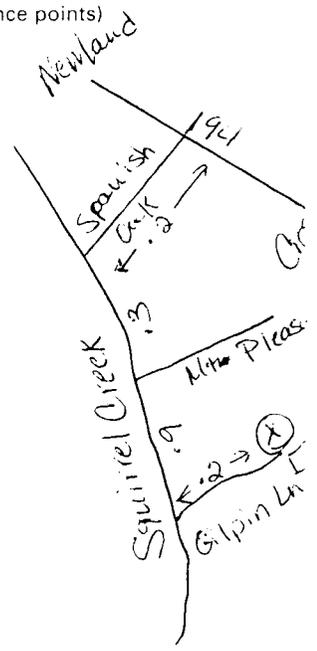

14. GROUT:

From	To	Depth	Material	Method
0	20	Ft.	Cement	Gravity Flow
20	_____	_____	_____	_____

15. SCREEN:

From	To	Depth	Diameter	Slot Size	Material
_____	_____	_____	_____	_____	_____
_____	_____	_____	_____	_____	_____
_____	_____	_____	_____	_____	_____

16. SAND/GRAVEL PACK:

From	To	Depth	Size	Material
_____	_____	_____	_____	_____
_____	_____	_____	_____	_____

17. REMARKS:
 I DO HEREBY CERTIFY THAT THIS WELL WAS CONSTRUCTED IN ACCORDANCE WITH 15A NCAC 2C, WELL CONSTRUCTION STANDARDS, AND THAT A COPY OF THIS RECORD HAS BEEN PROVIDED TO THE WELL OWNER.

Steve A Reece 1-31-01
 SIGNATURE OF PERSON CONSTRUCTING THE WELL DATE

Submit original to Division of Water Quality, Groundwater Section within 30 days GW-1 REV. 12/99

FOR OFFICE USE ONLY
 Quad No: _____
 Serial No: _____