

226756

WELL CONSTRUCTION RECORD

010008

WELL CONTRACTOR: Dewey Wright Well Pump Co., Inc
 WELL CONTRACTOR CERTIFICATION #: 2687
 STATE WELL CONSTRUCTION PERMIT#: Steve Reece

1. WELL USE (Check Applicable Box): Residential Municipal Industrial Agricultural Monitoring
 Recovery Heat Pump Water Injection Other If Other, List Use: _____

2. WELL LOCATION: (Show sketch of the location below)
 Nearest Town: SPRUCE PINE County: AVERY
BENT RD. OFF HWY 19E
(Road Name and Numbers, Community, or Subdivision and Lot No.)

3. _____
 4. DATE DRILLED 1/24/2001
 5. TOTAL DEPTH 225
 6. CUTTINGS COLLECTED YES NO
 7. DOES WELL REPLACE EXISTING WELL? YES NO
 8. STATIC WATER LEVEL Below Top of Casing: 40 FT.
(Use "+" if Above Top of Casing)

DRILLING LOG		DEPTH	Formation Description
From	To		
0	50		DIRT
50	190		GRANITE
190	193		QUARTZ
193	225		GRANITE
			01 MAR + 2 PM 2:41 OWN CIRCUMWATER SECTION RECEIVED/DEPOSITED


9. TOP OF CASING IS 1 FT. Above Land Surface*
*Top of casing terminated at/or below land surface requires a variance in accordance with 15A NCAC 2C.0118
 10. YIELD (gpm): 30 METHOD OF TEST Air
 11. WATER ZONES (depth):

<u>30</u> gpm	<u>190-193</u>	<u>0</u> gpm
<u>0</u> gpm		<u>0</u> gpm

 12. CHLORINATION: Type HTH Amount 39

13. CASING:

From	To	Depth	Diameter	Wall Thickness or Weight/Ft.	Material
<u>0</u>	<u>57</u>	<u>Ft.</u>	<u>6 1/8</u>	<u>.350</u>	<u>PVC</u>
From _____	To _____	Ft. _____	_____	_____	_____
From _____	To _____	Ft. _____	_____	_____	_____

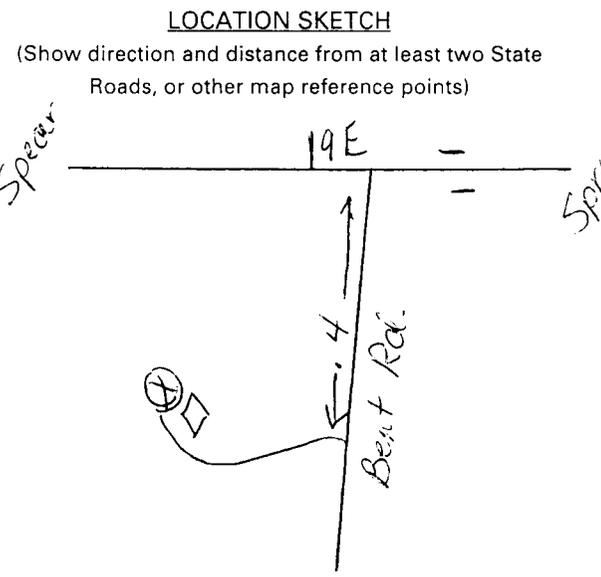

14. GROUT:

From	To	Depth	Material	Method
<u>0</u>	<u>20</u>	<u>Ft.</u>	<u>Cement</u>	<u>Gravity Flow</u>
From _____	To _____	Ft. _____	_____	_____

15. SCREEN:

From	To	Depth	Diameter	Slot Size	Material
From _____	To _____	Ft. _____	in. _____	in. _____	_____
From _____	To _____	Ft. _____	in. _____	in. _____	_____
From _____	To _____	Ft. _____	in. _____	in. _____	_____

16. SAND/GRAVEL PACK:

From	To	Depth	Size	Material
From _____	To _____	Ft. _____	_____	_____
From _____	To _____	Ft. _____	_____	_____

17. REMARKS: _____
 I DO HEREBY CERTIFY THAT THIS WELL WAS CONSTRUCTED IN ACCORDANCE WITH 15A NCAC 2C, WELL CONSTRUCTION STANDARDS, AND THAT A COPY OF THIS RECORD HAS BEEN PROVIDED TO THE WELL OWNER.

FOR OFFICE USE ONLY
 Quad No: _____
 Serial No. _____
 Groundwater Section
 with Regional Office

Steve Reece 2-27-01
 SIGNATURE OF PERSON CONSTRUCTING THE WELL DATE
 Submit original to Division of Water Quality, Groundwater Section within 30 days
 GW-1 REV. 12/99