

WELL CONSTRUCTION RECORD

010156

WELL CONTRACTOR: Dewey Wright Well Pump Co., Inc.
 WELL CONTRACTOR CERTIFICATION #: 2781
 STATE WELL CONSTRUCTION PERMIT#: Albert Slate

1. WELL USE (Check Applicable Box): Residential Municipal Industrial Agricultural Monitoring
 Recovery Heat Pump Water Injection Other If Other, List Use: _____

2. WELL LOCATION: (Show sketch of the location below)
 Nearest Town: LINNVILLE County: AVERY
DEV. RD. IN GLENN OF GRDFTHR OFF HWY 105
(Road Name and Numbers, Community, or Subdivision and Lot No.)

DRILLING LOG		DEPTH
From	To	Formation Description
0	30	DIRT/BOULDERS
30	40	BRN SHALE
40	43	CREVICE
43	50	SHALE
50	110	GRANITE
110	112	CREVICE
112	120	GRANITE

4. DATE DRILLED 3/18/2001
 5. TOTAL DEPTH 120
 6. CUTTINGS COLLECTED YES NO
 7. DOES WELL REPLACE EXISTING WELL? YES NO
 8. STATIC WATER LEVEL Below Top of Casing: 20 FT.
(Use "+" if Above Top of Casing)

9. TOP OF CASING IS 1 FT. Above Land Surface*
*Top of casing terminated at/or below land surface requires a variance in accordance with 15A NCAC 2C.0118

10. YIELD (gpm): 20 METHOD OF TEST Air
 11. WATER ZONES (depth): 15 gpm 40-43 5 gpm 110-112
0 gpm 0 gpm

12. CHLORINATION: Type HTH Amount 21

13. CASING:

From	Depth	To	Diameter	Wall Thickness or Weight/Ft.	Material
0		31 Ft.	6 1/8	.350	PVC
From		To	Ft.		
From		To	Ft.		

14. GROUT:

From	Depth	To	Material	Method
0		20 Ft.	Cement	Gravity Flow
From		To	Ft.	

15. SCREEN:


From	Depth	To	Diameter	Slot Size	Material	
From		To	Ft.	in.	in.	
From		To	Ft.	in.	in.	
From		To	Ft.	in.	in.	

16. SAND/GRAVEL PACK:

From	Depth	To	Size	Material
From		To	Ft.	
From		To	Ft.	

17. REMARKS: _____

LOCATION SKETCH
 (Show direction and distance from at least two State Roads, or other map reference points)

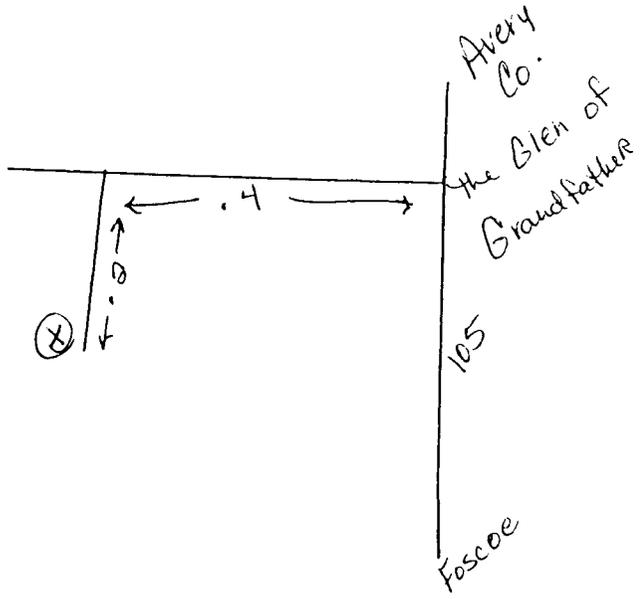

RECEIVED/DENR
 DOW GROUNDWATER SECTION
 01 APR 26 PM 2:22

I DO HEREBY CERTIFY THAT THIS WELL WAS CONSTRUCTED IN ACCORDANCE WITH 15A NCAC 2C, WELL CONSTRUCTION STANDARDS, AND THAT A COPY OF THIS RECORD HAS BEEN PROVIDED TO THE WELL OWNER.

FOR OFFICE USE ONLY

Quad No: _____

Serial No. _____

Albert L. Slate

4-18-01

SIGNATURE OF PERSON CONSTRUCTING THE WELL DATE
 Submit original to Division of Water Quality, Groundwater Section within 30 days