

229900

WELL CONSTRUCTION RECORD

010195

WELL CONTRACTOR: Dewey Wright Well Pump Co., Inc.
 WELL CONTRACTOR CERTIFICATION #: 2888
 STATE WELL CONSTRUCTION PERMIT#: Leslie Reece

1. WELL USE (Check Applicable Box): Residential Municipal Industrial Agricultural Monitoring
 Recovery Heat Pump Water Injection Other If Other, List Use: _____

2. WELL LOCATION: (Show sketch of the location below)
 Nearest Town: LINNVILLE County: EVERY
EDGE MONT RD. OFF HWY 221 OFF HWY 105
(Road Name and Numbers, Community, or Subdivision and Lot No.)

3. DATE DRILLED 3/26/2001
 4. TOTAL DEPTH 245
 5. CUTTINGS COLLECTED YES NO
 6. DOES WELL REPLACE EXISTING WELL? YES NO
 7. STATIC WATER LEVEL Below Top of Casing: 40 FT.
(Use "+" if Above Top of Casing)

DRILLING LOG		DEPTH
From	To	Formation Description
0	108	DIRT
108	125	GRANITE
125	126	QUARTZ
126	203	GRANITE
203	204	QUARTZ
204	245	GRANITE


9. TOP OF CASING IS 1 FT. Above Land Surface*
*Top of casing terminated at/or below land surface requires a variance in accordance with 15A NCAC 2C.0118
 10. YIELD (gpm): 12 METHOD OF TEST Air
 11. WATER ZONES (depth): 8 gpm 125-126 8 gpm 203-204
0 gpm 0 gpm
 12. CHLORINATION: Type HTH Amount 43

RECEIVED / DENR
 DWD GROUNDWATER SECTION
 01 APR 26 PM 2: 23

13. CASING:

From	To	Depth	Diameter	Wall Thickness or Weight/Ft.	Material
0	145	Ft.	8 1/4	188	GALV.
145	245	Ft.			

LOCATION SKETCH
 (Show direction and distance from at least two State Roads, or other map reference points)

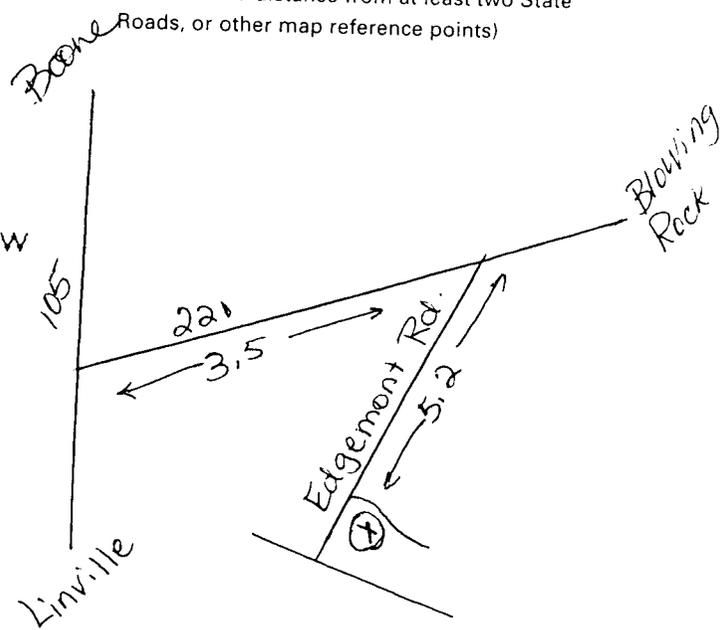

14. GROUT:

From	To	Depth	Material	Method
0	20	Ft.	Cement	Gravity Flow
20	245	Ft.	CEMENT	GRAVITY FLOW

15. SCREEN:

From	To	Depth	Diameter	Slot Size	Material
		Ft.	in.	in.	

16. SAND/GRAVEL PACK:

From	To	Depth	Size	Material
		Ft.		

17. REMARKS:
 I DO HEREBY CERTIFY THAT THIS WELL WAS CONSTRUCTED IN ACCORDANCE WITH 15A NCAC 2C, WELL CONSTRUCTION STANDARDS, AND THAT A COPY OF THIS RECORD HAS BEEN PROVIDED TO THE WELL OWNER.

FOR OFFICE USE ONLY
 Quad No: _____
 Serial No: _____

Leslie Wayne Reece 4-18-01
 SIGNATURE OF PERSON CONSTRUCTING THE WELL DATE
 Submit original to Division of Water Quality, Groundwater Section within 30 days