

259114

WELL CONSTRUCTION RECORD

WELL CONTRACTOR: Dewey Wright Well Pump Co., Inc.
 WELL CONTRACTOR CERTIFICATION #: 2787
 STATE WELL CONSTRUCTION PERMIT#: Jerry Wilson

020131

1. WELL USE (Check Applicable Box): Residential Municipal Industrial Agricultural Monitoring
 Recovery Heat Pump Water Injection Other If Other, List Use: _____

2. WELL LOCATION: (Show sketch of the location below)
 Nearest Town: MARION County: AVERY
FAE MCKINNEY RD. OFF BIG PLUMTREE CRK RD. OFF
(Road Name and Numbers, Community, or Subdivision and Lot No.)

3. DATE DRILLED 4/15/2002
 4. TOTAL DEPTH 425
 5. CUTTINGS COLLECTED YES NO
 6. DOES WELL REPLACE EXISTING WELL? YES NO
 7. STATIC WATER LEVEL Below Top of Casing: 50 FT.
(Use "+" if Above Top of Casing)
 8. TOP OF CASING IS 1 FT. Above Land Surface*
*Top of casing terminated at/or below land surface requires a variance in accordance with 15A NCAC 2C.0118
 9. YIELD (gpm): 2 METHOD OF TEST Air
 10. WATER ZONES (depth): 2 gpm 395-398 0 gpm
0 gpm 0 gpm
 11. CHLORINATION: Type HTH Amount 74

DRILLING LOG		DEPTH
From	To	Formation Description
0	47	DIRT/SHALE
47	395	GRANITE/QUARTZ
395	398	GRANITE
398	425	GRANITE


RECEIVED / IDENTIFICATION
DWD GROUNDWATER SECTION
02 MAY 23 PM 3:53

If additional space is needed use back of form

13. CASING:

From	To	Depth	Diameter	Wall Thickness or Weight/Ft.	Material
0	51 Ft.		6 1/8	.350	PVC
51	_____	_____	_____	_____	_____
_____	_____	_____	_____	_____	_____

LOCATION SKETCH
 (Show direction and distance from at least two State Roads, or other map reference points)

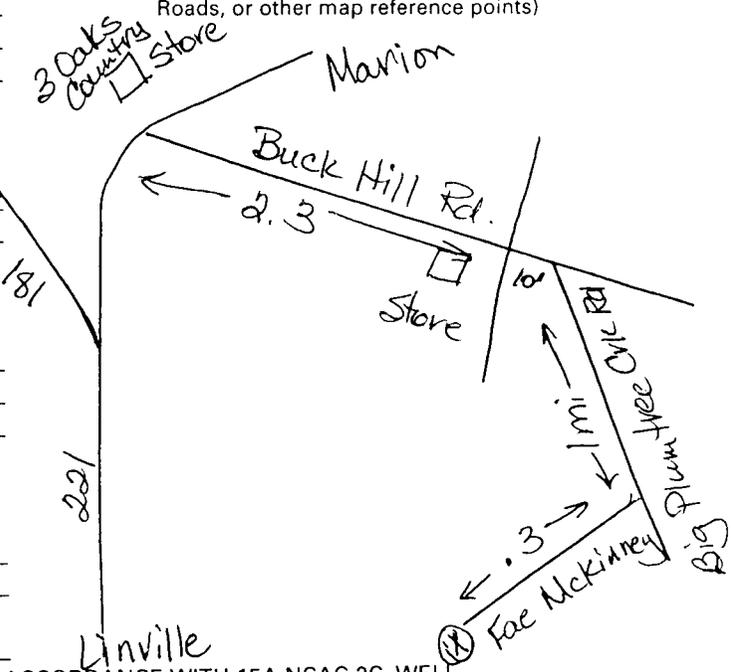

14. GROUT:

From	To	Depth	Material	Method
0	20	Ft.	Cement	Gravity Flow
20	_____	_____	_____	_____

15. SCREEN:

From	To	Depth	Diameter	Slot Size	Material
_____	_____	_____	_____	_____	_____
_____	_____	_____	_____	_____	_____

16. SAND/GRAVEL PACK:

From	To	Depth	Size	Material
_____	_____	_____	_____	_____
_____	_____	_____	_____	_____

17. REMARKS:
 I HEREBY CERTIFY THAT THIS WELL WAS CONSTRUCTED IN ACCORDANCE WITH 15A NCAC 2C, WELL CONSTRUCTION STANDARDS, AND THAT A COPY OF THIS RECORD HAS BEEN PROVIDED TO THE WELL OWNER.
Wayne Wilson 5-16-2002
 SIGNATURE OF PERSON CONSTRUCTING THE WELL DATE

FOR OFFICE USE ONLY
 Quad No: _____