

253115

# WELL CONSTRUCTION RECORD

WELL CONTRACTOR: Dewey Wright Well Pump Co., Inc.  
 WELL CONTRACTOR CERTIFICATION #: 2797  
 STATE WELL CONSTRUCTION PERMIT#: Jerry Wilson

020221

1. WELL USE (Check Applicable Box): Residential  Municipal  Industrial  Agricultural  Monitoring   
 Recovery  Heat Pump Water Injection  Other  If Other, List Use: \_\_\_\_\_

2. WELL LOCATION: (Show sketch of the location below)  
 Nearest Town: BANNER ELK County: AVERY  
PRIVATE RD. OFF OLD BEECH MTN RD. OFF SAM ELLE  
(Road Name and Numbers, Community, or Subdivision and Lot No.)

3. DRILLING LOG

From	To	DEPTH	Formation Description
0	8		DIRT
8	385		GRANITE/QUARTZ
385	388		GRANITE
388	405		GRANITE/QUARTZ

4. DATE DRILLED 4/16/2002  
 5. TOTAL DEPTH 405  
 6. CUTTINGS COLLECTED YES  NO   
 7. DOES WELL REPLACE EXISTING WELL? YES  NO   
 8. STATIC WATER LEVEL Below Top of Casing: 80 FT.  
(Use "+" if Above Top of Casing)

9. TOP OF CASING IS 1 FT. Above Land Surface\*  
\*Top of casing terminated at/or below land surface requires a variance in accordance with 15A NCAC 2C.0118

10. YIELD (gpm): 20 METHOD OF TEST Air

11. WATER ZONES (depth): 20 gpm 385-388 0 gpm  
0 gpm 0 gpm


12. CHLORINATION: Type HTH Amount 67

RECEIVED / DENR  
 DIV. OF GROUNDWATER SECTION  
 02 MAY 23 PM 3:33

If additional space is needed use back of form

13. CASING:

From	To	Depth	Diameter	Wall Thickness or Weight/Ft.	Material
0	20	Ft.	6 1/4	188	Galv
20		Ft.			
		Ft.			

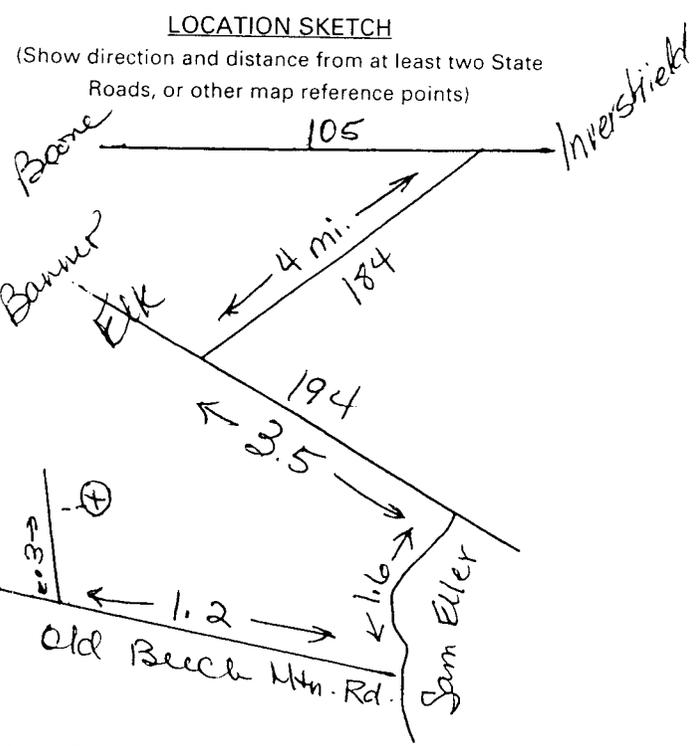

14. GROUT:

From	To	Depth	Material	Method
0	20	Ft.	Cement	Gravity Flow
		Ft.		

15. SCREEN:

From	To	Depth	Diameter	Slot Size	Material
		Ft.	in.	in.	
		Ft.	in.	in.	
		Ft.	in.	in.	

16. SAND/GRAVEL PACK:

From	To	Depth	Size	Material
		Ft.		
		Ft.		

17. REMARKS:

I DO HEREBY CERTIFY THAT THIS WELL WAS CONSTRUCTED IN ACCORDANCE WITH 15A NCAC 2C, WELL CONSTRUCTION STANDARDS, AND THAT A COPY OF THIS RECORD HAS BEEN PROVIDED TO THE WELL OWNER.

**FOR OFFICE USE ONLY**  
 Quad No: \_\_\_\_\_

*Wayne Wilson* 5-16-2002  
 SIGNATURE OF PERSON CONSTRUCTING THE WELL DATE  
 Submit original to Division of Water Quality, Groundwater Section within 30 days  
 GW-1 REV. 12/99