

254516

WELL CONSTRUCTION RECORD

WELL CONTRACTOR: Dewey Wright Well Pump Co., Inc.
 WELL CONTRACTOR CERTIFICATION #: 2888
 STATE WELL CONSTRUCTION PERMIT#: Leslie Reece

020317

1. WELL USE (Check Applicable Box): Residential Municipal Industrial Agricultural Monitoring
 Recovery Heat Pump Water Injection Other If Other, List Use: _____

2. WELL LOCATION: (Show sketch of the location below)
 Nearest Town: BANNER ELK County: AVERY
OLD FARM RD OFF LEE GUALTNEY WAY OFF HWY 194
(Road Name and Numbers, Community, or Subdivision and Lot No.)

3. _____
 4. DATE DRILLED 5/22/2002
 5. TOTAL DEPTH 125
 6. CUTTINGS COLLECTED YES NO
 7. DOES WELL REPLACE EXISTING WELL? YES NO
 8. STATIC WATER LEVEL Below Top of Casing: 10 FT.
(Use "+" if Above Top of Casing)
 9. TOP OF CASING IS 1 FT. Above Land Surface*
*Top of casing terminated at/or below land surface requires a variance in accordance with 15A NCAC 2C.0118
 10. YIELD (gpm): 20 METHOD OF TEST Air
 11. WATER ZONES (depth): 5 gpm 34-38 15 gpm 91-92
0 gpm 0 gpm
 12. CHLORINATION: Type HTH Amount 23


DRILLING LOG		DEPTH
From	To	Formation Description
0	23	DIRT
23	34	GRANITE
34	38	SHALE
38	91	GRANITE
91	92	SHALE
92	125	GRANITE

RECEIVED/DENR DIVISION OF GROUNDWATER SECTION 02 JUN 17 PM 4:28

If additional space is needed use back of form

13. CASING:

From	Depth	To	Diameter	Wall Thickness or Weight/Ft.	Material
0		28	6 1/8	.350	PVC
_____		_____	_____	_____	_____
_____		_____	_____	_____	_____

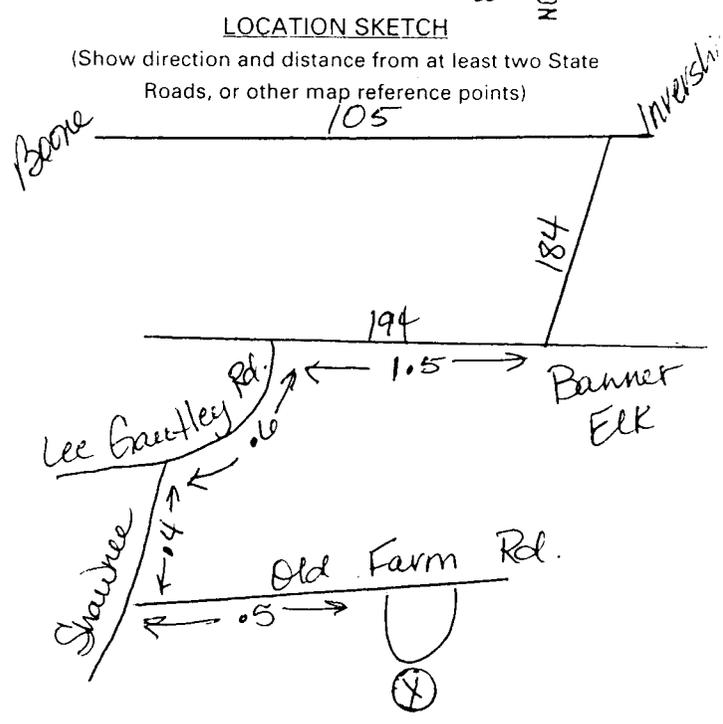

14. GROUT:

From	Depth	To	Material	Method
0		20	Cement	Gravity Flow
_____		_____	_____	_____

15. SCREEN:


From	Depth	To	Diameter	Slot Size	Material
_____	_____	_____	_____	_____	_____
_____	_____	_____	_____	_____	_____
_____	_____	_____	_____	_____	_____

16. SAND/GRAVEL PACK:

From	Depth	To	Size	Material
_____	_____	_____	_____	_____
_____	_____	_____	_____	_____

17. REMARKS:
 I DO HEREBY CERTIFY THAT THIS WELL WAS CONSTRUCTED IN ACCORDANCE WITH 15A NCAC 2C, WELL CONSTRUCTION STANDARDS, AND THAT A COPY OF THIS RECORD HAS BEEN PROVIDED TO THE WELL OWNER.

 SIGNATURE OF PERSON CONSTRUCTING THE WELL
 DATE 6-7-02

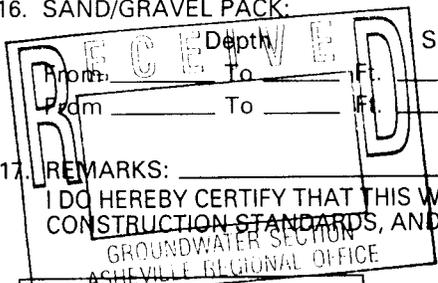

FOR OFFICE USE ONLY
 Quad No: _____
 Serial No: _____