

257212

WELL CONSTRUCTION RECORD

WELL CONTRACTOR: Dewey Wright Well Pump Co., Inc.
 WELL CONTRACTOR CERTIFICATION #: 2878
 STATE WELL CONSTRUCTION PERMIT#: Steve Price

020384

1. WELL USE (Check Applicable Box): Residential Municipal Industrial Agricultural Monitoring
 Recovery Heat Pump Water Injection Other If Other, List Use: _____

2. WELL LOCATION: (Show sketch of the location below)
 Nearest Town: BOONE County: AVERY
HWY 321 OFF HWY 321
(Road Name and Numbers, Community, or Subdivision and Lot No.)

3. DATE DRILLED 7/9/2002
 4. TOTAL DEPTH 325
 5. CUTTINGS COLLECTED YES NO
 6. DOES WELL REPLACE EXISTING WELL? YES NO
 7. STATIC WATER LEVEL Below Top of Casing: 80 FT.
(Use "+" if Above Top of Casing)

DRILLING LOG		DEPTH
From	To	Formation Description
0	40	DIRT
40	60	SHALE
60	120	GRANITE
120	170	GRANITE
170	240	GRANITE QUARTZ
240	325	GRANITE


02 AUG - 5 AM 11:52
 DIVISION OF WATER QUALITY
 RECEIVED/ENTER

9. TOP OF CASING IS 1 FT. Above Land Surface*
*Top of casing terminated at/or below land surface requires a variance in accordance with 15A NCAC 2C.0118
 10. YIELD (gpm): 1 gpm 120-170 0 gpm
 11. WATER ZONES (depth): 0 gpm 0 gpm
 12. CHLORINATION: Type HTH Amount 54

13. CASING:

From	To	Depth	Diameter	Wall Thickness or Weight/Ft.	Material
0	45	Ft.	8 1/8	.350	PVC
From	To	Ft.			
From	To	Ft.			

LOCATION SKETCH
 (Show direction and distance from at least two State Roads, or other map reference points)

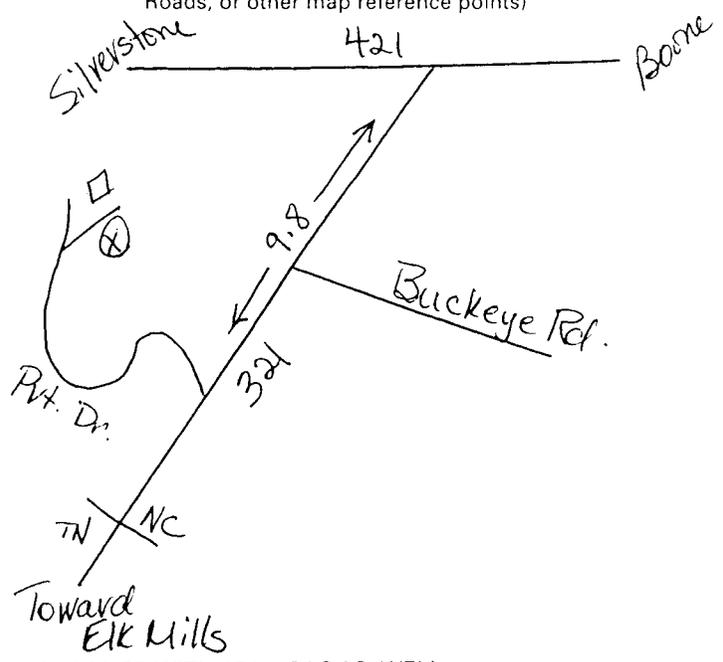

14. GROUT:

From	To	Depth	Material	Method
0	20	Ft.	Cement	Gravity Flow
From	To	Ft.		

15. SCREEN:

From	To	Depth	Diameter	Slot Size	Material
From	To	Ft.	in.	in.	
From	To	Ft.	in.	in.	
From	To	Ft.	in.	in.	

16. SAND/GRAVEL PACK:

From	To	Depth	Size	Material
From	To	Ft.		
From	To	Ft.		

17. REMARKS:
 I DO HEREBY CERTIFY THAT THIS WELL WAS CONSTRUCTED IN ACCORDANCE WITH 15A NCAC 2C, WELL CONSTRUCTION STANDARDS, AND THAT A COPY OF THIS RECORD HAS BEEN PROVIDED TO THE WELL OWNER.

Steve Price
 SIGNATURE OF PERSON CONSTRUCTING THE WELL
 DATE 7-29-02

FOR OFFICE USE ONLY

Quad No: _____
 Serial No: _____
 GROUNDWATER SECTION
 AVERY REGIONAL OFFICE

Submit original to Division of Water Quality, Groundwater Section within 30 days
 GW-1 REV. 12/99