

257242

WELL CONSTRUCTION RECORD

020403

WELL CONTRACTOR: Dewey Wright Well Pump Co., Inc.
 WELL CONTRACTOR CERTIFICATION #: 2797
 STATE WELL CONSTRUCTION PERMIT#: Jerry Wilson

1. WELL USE (Check Applicable Box): Residential Municipal Industrial Agricultural Monitoring
 Recovery Heat Pump Water Injection Other If Other, List Use: _____

2. WELL LOCATION: (Show sketch of the location below)
 Nearest Town: ELK PARK County: AVERY
PRIVATE DR. OFF BILL YOUNG RD. OFF BARLOWE RD.
(Road Name and Numbers, Community, or Subdivision and Lot No.)

DRILLING LOG		DEPTH
From	To	Formation Description
0	100	DIRT/SHALE/GRANITE
100	115	GRANITE
115	118	GRANITE
118	210	GRANITE/QUARTZ
210	211	QUARTZ
211	225	GRANITE

4. DATE DRILLED 7/2/2002
 5. TOTAL DEPTH 225
 6. CUTTINGS COLLECTED YES NO
 7. DOES WELL REPLACE EXISTING WELL? YES NO
 8. STATIC WATER LEVEL Below Top of Casing: 50 FT.
(Use "+" if Above Top of Casing)

9. TOP OF CASING IS 1 FT. Above Land Surface*
*Top of casing terminated at/or below land surface requires a variance in accordance with 15A NCAC 2C.0118

10. YIELD (gpm): 30 METHOD OF TEST Air
 11. WATER ZONES (depth): 2 gpm 115-116 28 gpm 210-211
0 gpm 0 gpm

12. CHLORINATION: Type HTH Amount 36

13. CASING:

From	To	Depth	Diameter	Wall Thickness or Weight/Ft.	Material
0	108	Ft.	6 1/8	.350	PVC
From	To	Ft.			
From	To	Ft.			

14. GROUT:

From	To	Depth	Material	Method
0	20	Ft.	Cement	Gravity Flow
From	To	Ft.		


15. SCREEN:

From	To	Depth	Diameter	Slot Size	Material
From	To	Ft.	in.	in.	
From	To	Ft.	in.	in.	
From	To	Ft.	in.	in.	

16. SAND/GRAVEL PACK:

From	To	Depth	Size	Material
From	To	Ft.		
From	To	Ft.		

17. REMARKS:
 I DO HEREBY CERTIFY THAT THIS WELL WAS CONSTRUCTED IN ACCORDANCE WITH 15A NCAC 2C, WELL CONSTRUCTION STANDARDS, AND THAT A COPY OF THIS RECORD HAS BEEN PROVIDED TO THE WELL OWNER.

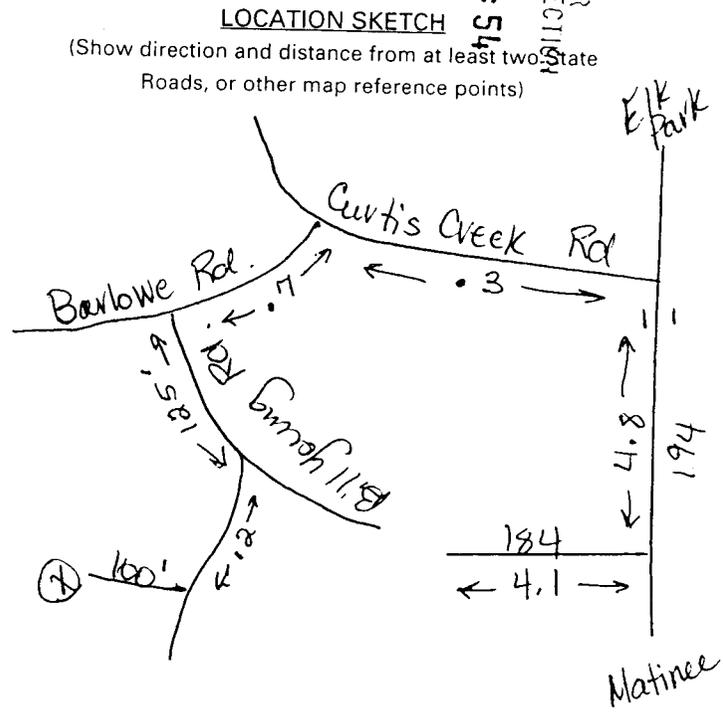

RECEIVED DIVISION OF WATER QUALITY SECTION
 02 AUG - 5 AM 11:54

FOR OFFICE USE ONLY

Signature of Person Constructing the Well: Wayne Wilson DATE: 7-23-2002
 Quad No: _____ Submit original to Division of Water Quality, Groundwater Section within 30 days
 GW-1 REV. 12/99