

260667

**WELL CONSTRUCTION RECORD**

WELL CONTRACTOR: Dewey Wright Well Pump Co., Inc.  
 WELL CONTRACTOR CERTIFICATION #: 2681  
 STATE WELL CONSTRUCTION PERMIT#: Steve Felty

020487

1. WELL USE (Check Applicable Box): Residential  Municipal  Industrial  Agricultural  Monitoring   
 Recovery  Heat Pump Water Injection  Other  If Other, List Use: \_\_\_\_\_

2. WELL LOCATION: (Show sketch of the location below)  
 Nearest Town: BLOWING ROCK County: AVERY  
WILD APPLE DR. OFF HWY 221  
(Road Name and Numbers, Community, or Subdivision and Lot No.)

3. \_\_\_\_\_  
 4. DATE DRILLED 8/1/2002  
 5. TOTAL DEPTH 305  
 6. CUTTINGS COLLECTED YES  NO   
 7. DOES WELL REPLACE EXISTING WELL? YES  NO   
 8. STATIC WATER LEVEL Below Top of Casing: 30 FT.  
(Use "+" if Above Top of Casing)


DRILLING LOG		DEPTH
From	To	Formation Description
0	3	DIRT
3	50	GRANITE
50	52	SHALE
52	270	GRANITE
270	272	QUARTZ
272	305	GRANITE

If additional space is needed use back of form

9. TOP OF CASING IS 1 FT. Above Land Surface\*  
\*Top of casing terminated at/or below land surface requires a variance in accordance with 15A NCAC 2C.0118  
 10. YIELD (gpm): 3 METHOD OF TEST Air  
 11. WATER ZONES (depth): 1 gpm 50-52 2 gpm 270-272  
0 gpm 0 gpm  
 12. CHLORINATION: Type HTH Amount 58

13. CASING:  

From	Depth	To	Diameter	Wall Thickness or Weight/Ft.	Material
0		20	6 1/8	350	PVC
From	To	Ft.			
From	To	Ft.			

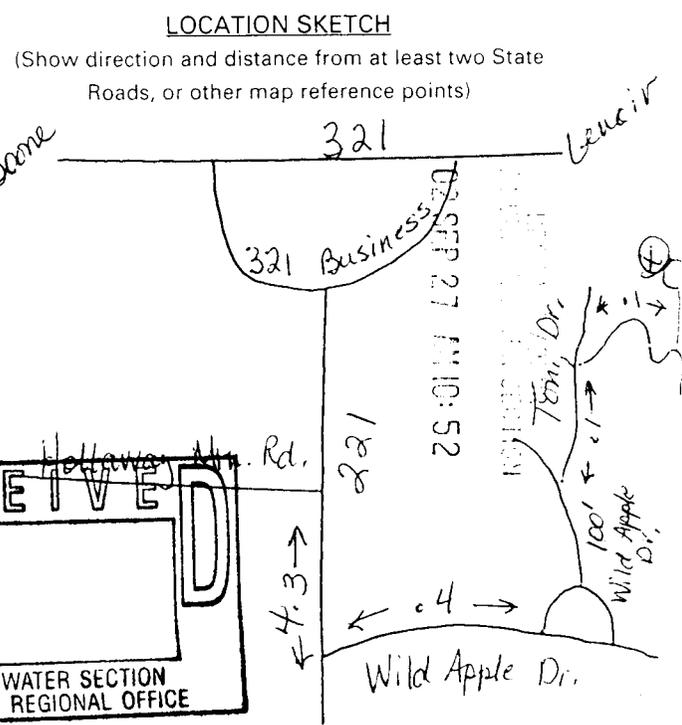

14. GROUT:  


From	Depth	To	Material	Method
0		20	Cement	Gravity Flow
From	To	Ft.		
From	To	Ft.		

15. SCREEN:  

From	Depth	To	Diameter	Slot Size	Material
From	To	Ft.	in.	in.	
From	To	Ft.	in.	in.	
From	To	Ft.	in.	in.	

16. SAND/GRAVEL PACK:  

From	Depth	To	Size	Material
From	To	Ft.		
From	To	Ft.		

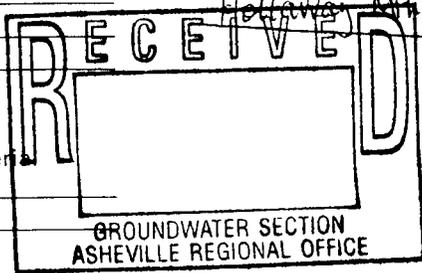

17. REMARKS: \_\_\_\_\_  
 I DO HEREBY CERTIFY THAT THIS WELL WAS CONSTRUCTED IN ACCORDANCE WITH 15A NCAC 2C, WELL CONSTRUCTION STANDARDS, AND THAT A COPY OF THIS RECORD HAS BEEN PROVIDED TO THE WELL OWNER.

FOR OFFICE USE ONLY  
 Quad No: \_\_\_\_\_  
 Serial No: \_\_\_\_\_

Steve Felty  
 SIGNATURE OF PERSON CONSTRUCTING THE WELL  
 Submit original to Division of Water Quality, Groundwater Section within 30 days  
 DATE 9-11-02  
 GW-1 REV. 12/99