

260683

WELL CONSTRUCTION RECORD

WELL CONTRACTOR: Dewey Wright Well Pump Co., Inc.
 WELL CONTRACTOR CERTIFICATION #: 2787
 STATE WELL CONSTRUCTION PERMIT#: Jerry Wilson

020470

1. WELL USE (Check Applicable Box): Residential Municipal Industrial Agricultural Monitoring
 Recovery Heat Pump Water Injection Other If Other, List Use: _____

2. WELL LOCATION: (Show sketch of the location below)
 Nearest Town: NEWLAND County: AVERY
PRIVATE DR. OFF KATE DAVIS LANE OFF OLD 19E OFF
(Road Name and Numbers, Community, or Subdivision and Lot No.)

DRILLING LOG		DEPTH
From	To	Formation Description
0	12	DIRT/GRAVEL
12	55	GRANITE
55	58	GRANITE
58	275	GRANITE/QUARTZ
275	278	GRANITE
278	305	GRANITE

3. DATE DRILLED 8/2/2002
 4. TOTAL DEPTH 305
 6. CUTTINGS COLLECTED YES NO
 7. DOES WELL REPLACE EXISTING WELL? YES NO
 8. STATIC WATER LEVEL Below Top of Casing: 20 FT.
(Use "+" if Above Top of Casing)

9. TOP OF CASING IS 1 FT. Above Land Surface*
*Top of casing terminated at or below land surface requires a variance in accordance with 15A NCAC 2C.0118

10. YIELD (gpm): 3 METHOD OF TEST Air
 11. WATER ZONES (depth): 1 apm 55-58 2 apm 275-278
0 apm 0 apm

12. CHLORINATION: Type HTH Amount 57

If additional space is needed use back of form

13. CASING:

From	Depth	To	Diameter	Wall Thickness or Weight/Ft.	Material
0		22	8 1/8	.350	PVC
From	To	Ft.			
From	To	Ft.			

14. GROUT:

From	Depth	To	Material	Method
0		20	Cement	Gravity Flow
From	To	Ft.		


15. SCREEN:

From	Depth	To	Diameter	Slot Size	Material
From	To	Ft.	in.	in.	
From	To	Ft.	in.	in.	
From	To	Ft.	in.	in.	

16. SAND/GRAVEL PACK:

From	Depth	To	Size	Material
From	To	Ft.		
From	To	Ft.		

17. REMARKS:

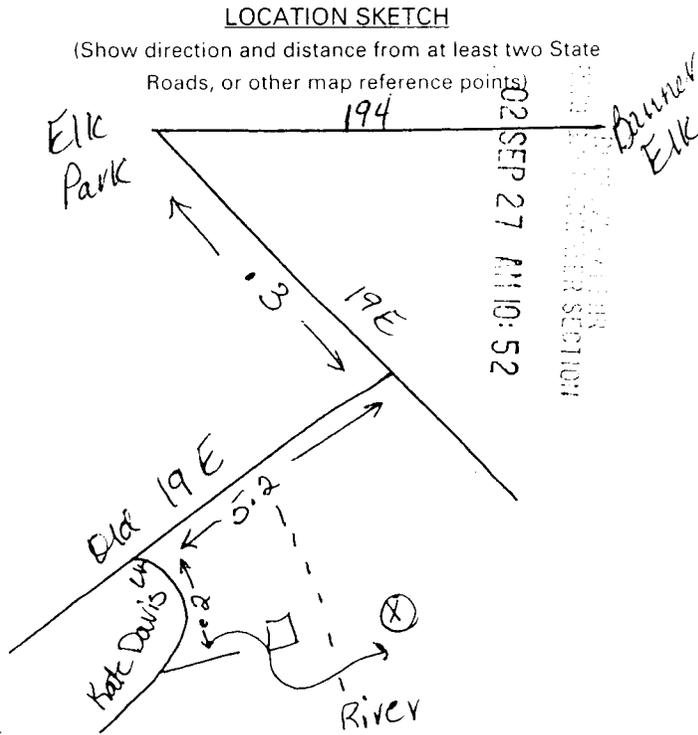

I DO HEREBY CERTIFY THAT THIS WELL WAS CONSTRUCTED IN ACCORDANCE WITH 15A NCAC 2C, WELL CONSTRUCTION STANDARDS, AND THAT A COPY OF THIS RECORD HAS BEEN PROVIDED TO THE WELL OWNER.

Jerry Wilson 9-11-2002
 SIGNATURE OF PERSON CONSTRUCTING THE WELL DATE

Submit original to Division of Water Quality, Groundwater Section within 30 days

FOR OFFICE USE ONLY
 Quad No: _____
 Serial No: _____