

261796

**WELL CONSTRUCTION RECORD**

020566

WELL CONTRACTOR: Dewey Wright Well Pump Co., Inc.  
 WELL CONTRACTOR CERTIFICATION #: 2887  
 STATE WELL CONSTRUCTION PERMIT#: Steve Reece

1. WELL USE (Check Applicable Box): Residential  Municipal  Industrial  Agricultural  Monitoring   
 Recovery  Heat Pump Water Injection  Other  If Other, List Use: \_\_\_\_\_

2. WELL LOCATION: (Show sketch of the location below)  
 Nearest Town: BOONE County: AVERY  
BUCKEYE RD. OFF HWY 321 OFF HWY 421  
(Road Name and Numbers, Community, or Subdivision and Lot No.)

3. DATE DRILLED 9/11/2002  
 4. TOTAL DEPTH 125  
 6. CUTTINGS COLLECTED YES  NO   
 7. DOES WELL REPLACE EXISTING WELL? YES  NO   
 8. STATIC WATER LEVEL Below Top of Casing: 20 FT.  
(Use "+" if Above Top of Casing)

DRILLING LOG		DEPTH
From	To	Formation Description
0	15	DIRT
15	37	GRANITE/SHALE
37	39	SHALE
39	68	GRANITE
68	71	SHALE
71	125	GRANITE


If additional space is needed use back of form

9. TOP OF CASING IS 1 FT. Above Land Surface\*  
\*Top of casing terminated at/or below land surface requires a variance in accordance with 15A NCAC 2C.0118  
 10. YIELD (gpm): 10 METHOD OF TEST Air  
 11. WATER ZONES (depth): 3 gpm 37-39 7 gpm 68-71  
0 gpm 0 gpm  
 12. CHLORINATION: Type HTH Amount 22

13. CASING:

From	To	Depth	Diameter	Wall Thickness or Weight/Ft.	Material
0	21	Ft.	6 1/4	.158	GALV.
From	To	Ft.			
From	To	Ft.			

**LOCATION SKETCH**  
 (Show direction and distance from at least two State Roads, or other map reference points)

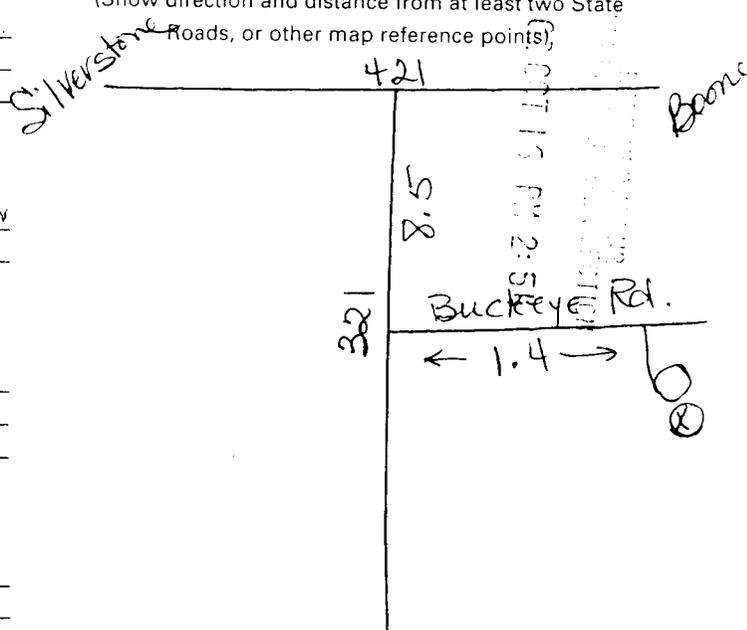

14. GROUT:

From	To	Depth	Material	Method
0	20	Ft.	Cement	Gravity Flow
From	To	Ft.		

15. SCREEN:

From	To	Depth	Diameter	Slot Size	Material
From	To	Ft.	in.	in.	
From	To	Ft.	in.	in.	
From	To	Ft.	in.	in.	

16. SAND/GRAVEL PACK:

From	To	Depth	Size	Material
From	To	Ft.		
From	To	Ft.		

17. REMARKS:  
 I DO HEREBY CERTIFY THAT THIS WELL WAS CONSTRUCTED IN ACCORDANCE WITH 15A NCAC 2C, WELL CONSTRUCTION STANDARDS, AND THAT A COPY OF THIS RECORD HAS BEEN PROVIDED TO THE WELL OWNER.

FOR OFFICE USE ONLY

Quad No: \_\_\_\_\_

Serial No: \_\_\_\_\_

Steve Reece 10-14-02  
 SIGNATURE OF PERSON CONSTRUCTING THE WELL DATE

Submit original to Division of Water Quality, Groundwater Section within 30 days

GROUNDWATER SECTION  
 ASHEVILLE REGIONAL OFFICE