

266905

WELL CONSTRUCTION RECORD

020981

WELL CONTRACTOR: Dewey Wright Well Pump Co., Inc.
 WELL CONTRACTOR CERTIFICATION #: 2681
 STATE WELL CONSTRUCTION PERMIT#: Steve Petty

1. WELL USE (Check Applicable Box): Residential Municipal Industrial Agricultural Monitoring
 Recovery Heat Pump Water Injection Other If Other, List Use: _____

2. WELL LOCATION: (Show sketch of the location below)
 Nearest Town: BANNER ELK County: AVERY
FLATSPRINGS RD 2/10 MILE OFF BUCKEYE RD.
(Road Name and Numbers, Community, or Subdivision and Lot No.)

3. _____
 4. DATE DRILLED 11/26/2002
 5. TOTAL DEPTH 205
 6. CUTTINGS COLLECTED YES NO
 7. DOES WELL REPLACE EXISTING WELL? YES NO
 8. STATIC WATER LEVEL Below Top of Casing: 50 FT.
(Use "+" if Above Top of Casing)

DRILLING LOG		DEPTH
From	To	Formation Description
0	35	DIRT
35	50	GRANITE
50	52	SHALE
52	130	GRANITE
130	132	SHALE
132	189	GRANITE
189	190	SHALE
190	205	GRANITE


If additional space is needed use back of form

9. TOP OF CASING IS 1 FT. Above Land Surface*
*Top of casing terminated at/or below land surface requires a variance in accordance with 15A NCAC 2C.0118
 10. YIELD (gpm): 4 METHOD OF TEST Air
 11. WATER ZONES (depth):
1 gpm 50-52 1 gpm 130-132
2 gpm 189-190 0 gpm

12. CHLORINATION: Type HTH Amount 31

13. CASING:

From	Depth To	Diameter	Wall Thickness or Weight/Ft.	Material
0	40 Ft.	6 1/8	.350	PVC
From	To	Ft.		
From	To	Ft.		

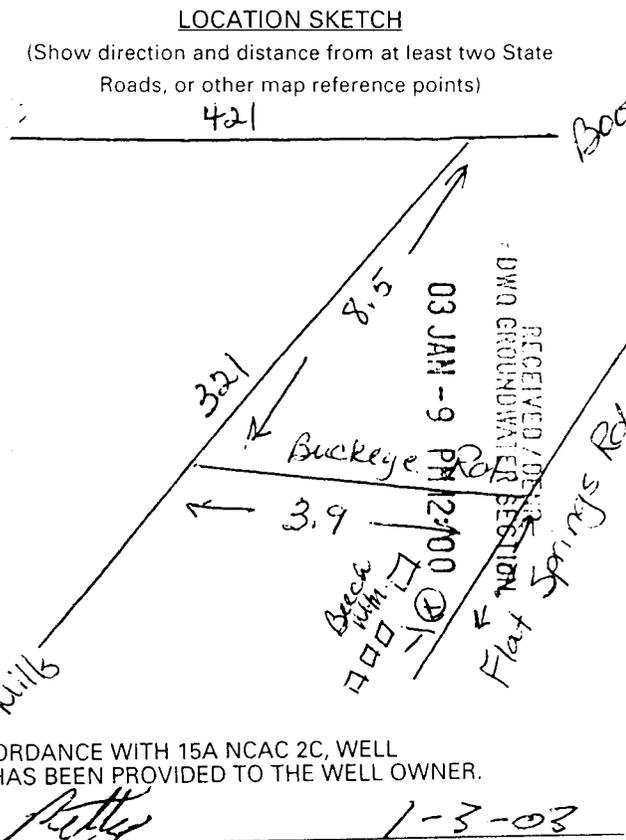

14. GROUT:

From	Depth To	Material	Method
0	20 Ft.	Cement	Gravity Flow
From	To	Ft.	
From	To	Ft.	

15. SCREEN:

From	Depth To	Diameter	Slot Size	Material
From	To	Ft.	in.	in.
From	To	Ft.	in.	in.
From	To	Ft.	in.	in.

16. SAND/GRAVEL PACK:

From	Depth To	Size	Material
From	To	Ft.	
From	To	Ft.	

17. REMARKS:
 I DO HEREBY CERTIFY THAT THIS WELL WAS CONSTRUCTED IN ACCORDANCE WITH 15A NCAC 2C, WELL CONSTRUCTION STANDARDS, AND THAT A COPY OF THIS RECORD HAS BEEN PROVIDED TO THE WELL OWNER.

Steve Petty 1-3-03
 SIGNATURE OF PERSON CONSTRUCTING THE WELL DATE

FOR OFFICE USE ONLY
 Quad No: _____
 Serial No. _____