

266933

WELL CONSTRUCTION RECORD

020719

WELL CONTRACTOR: Dewey Wright Well Pump Co., Inc.
 WELL CONTRACTOR CERTIFICATION #: 2881
 STATE WELL CONSTRUCTION PERMIT#: Steve Petty

1. WELL USE (Check Applicable Box): Residential Municipal Industrial Agricultural Monitoring
 Recovery Heat Pump Water Injection Other If Other, List Use: _____

2. WELL LOCATION: (Show sketch of the location below)
 Nearest Town: ELK PARK County: AVERY
PRIVATE DR. OFF BARLOW RD. OFF CURTIS CREEK R
(Road Name and Numbers, Community, or Subdivision and Lot No.)

DRILLING LOG **DEPTH**

From	To	Formation Description
0	40	DIRT
40	75	GRANITE
75	76	SHALE
76	106	GRANITE
106	108	SHALE
108	125	GRANITE

4. DATE DRILLED 11/20/2002
 5. TOTAL DEPTH 125
 6. CUTTINGS COLLECTED YES NO
 7. DOES WELL REPLACE EXISTING WELL? YES NO
 8. STATIC WATER LEVEL Below Top of Casing: 20 FT.
(Use "+" if Above Top of Casing)

9. TOP OF CASING IS 1 FT. Above Land Surface*
*Top of casing terminated at/or below land surface requires a variance in accordance with 15A NCAC 2C.0118

10. YIELD (gpm): 60 METHOD OF TEST Air
 11. WATER ZONES (depth): 2 gpm 75-76 58 gpm 106-108
0 gpm 0 gpm


12. CHLORINATION: Type HTH Amount 22

If additional space is needed use back of form

13. CASING:
 From 0 Depth To 45 Ft. Diameter 6 1/8 Wall Thickness or Weight/Ft. .350 Material PVC
 From _____ To _____ Ft. _____ _____
 From _____ To _____ Ft. _____ _____

LOCATION SKETCH

(Show direction and distance from at least two State Roads, or other map reference points)

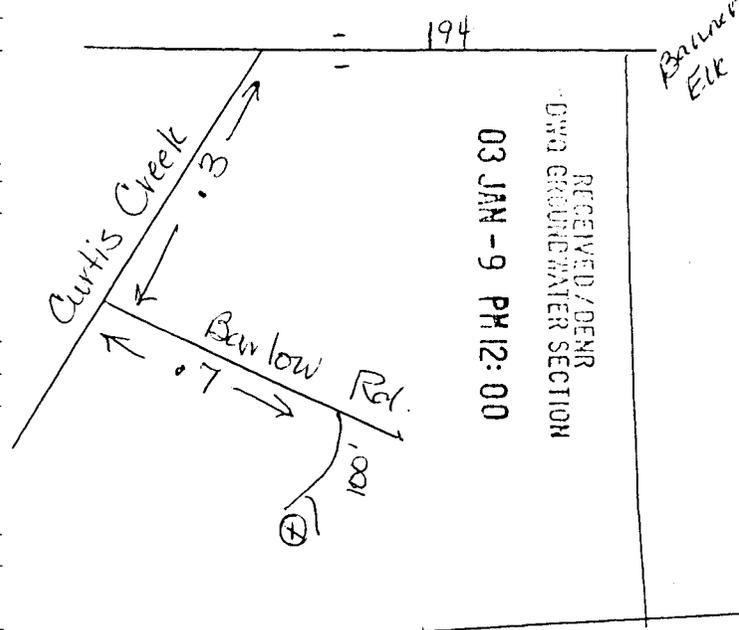

14. GROUT:
 From 0 Depth To 20 Ft. Material Cement Method Gravity Flow
 From _____ To _____ Ft. _____ _____

15. SCREEN:
 From _____ To _____ Ft. Diameter _____ Slot Size _____ Material _____
 From _____ To _____ Ft. _____ _____
 From _____ To _____ Ft. _____ _____

16. SAND/GRAVEL PACK:
 From _____ To _____ Ft. Size _____ Material _____
 From _____ To _____ Ft. _____ _____

17. REMARKS:
 I DO HEREBY CERTIFY THAT THIS WELL WAS CONSTRUCTED IN ACCORDANCE WITH 15A NCAC 2C, WELL CONSTRUCTION STANDARDS, AND THAT A COPY OF THIS RECORD HAS BEEN PROVIDED TO THE WELL OWNER.

Steve Petty

1-3-03

FOR OFFICE USE ONLY
 Quad No: _____
 Serial No. _____

SIGNATURE OF PERSON CONSTRUCTING THE WELL
 Submit original to Division of Water Quality, Groundwater Section within 30 days

DATE