

266934

WELL CONSTRUCTION RECORD

020920

WELL CONTRACTOR: Dewey Wright Well Pump Co. Inc.

WELL CONTRACTOR CERTIFICATION #: 2681

STATE WELL CONSTRUCTION PERMIT#: Steve Petty

1. WELL USE (Check Applicable Box): Residential Municipal Industrial Agricultural Monitoring
 Recovery Heat Pump Water Injection Other If Other, List Use: _____

2. WELL LOCATION: (Show sketch of the location below)
 Nearest Town: LINVILLE County: AVERY
SUGAR MTN # 1 OFF HWY 181 OFF HWY 105
(Road Name and Numbers, Community, or Subdivision and Lot No.)

3. DATE DRILLED 11/8/2002
 4. TOTAL DEPTH 120
 5. CUTTINGS COLLECTED YES NO
 6. DOES WELL REPLACE EXISTING WELL? YES NO
 7. STATIC WATER LEVEL Below Top of Casing: 30 FT.
(Use "+" if Above Top of Casing)
 8. TOP OF CASING IS 1 FT. Above Land Surface*
*Top of casing terminated at/or below land surface requires a variance in accordance with 15A NCAC 2C.0118
 9. YIELD (gpm): 20 METHOD OF TEST Air
 10. WATER ZONES (depth): 10 gpm 48-49 10 gpm 85-88
0 gpm 0 gpm
 11. CHLORINATION: Type HTH Amount 19

DRILLING LOG		DEPTH
From	To	Formation Description
0	40	DIRT
40	48	GRANITE
48	49	QUARTZ
49	85	GRANITE
85	88	SHALE
88	120	GRANITE

If additional space is needed use back of form


13. CASING:
 From 0 To 47 Ft. Depth Diameter 6 1/8 Wall Thickness or Weight/Ft. .350 Material PVC
 From _____ To _____ Ft. _____
 From _____ To _____ Ft. _____

14. GROUT:
 From 0 To 20 Ft. Depth Material Cement Method Gravity Flow
 From _____ To _____ Ft. _____

15. SCREEN:
 From _____ To _____ Ft. Depth Diameter Slot Size Material
 From _____ To _____ Ft. _____
 From _____ To _____ Ft. _____

16. SAND/GRAVEL PACK:
 From _____ To _____ Ft. Depth Size Material
 From _____ To _____ Ft. _____

17. REMARKS:
 I DO HEREBY CERTIFY THAT THIS WELL WAS CONSTRUCTED IN ACCORDANCE WITH 15A NCAC 2C, WELL CONSTRUCTION STANDARDS, AND THAT A COPY OF THIS RECORD HAS BEEN PROVIDED TO THE WELL OWNER.

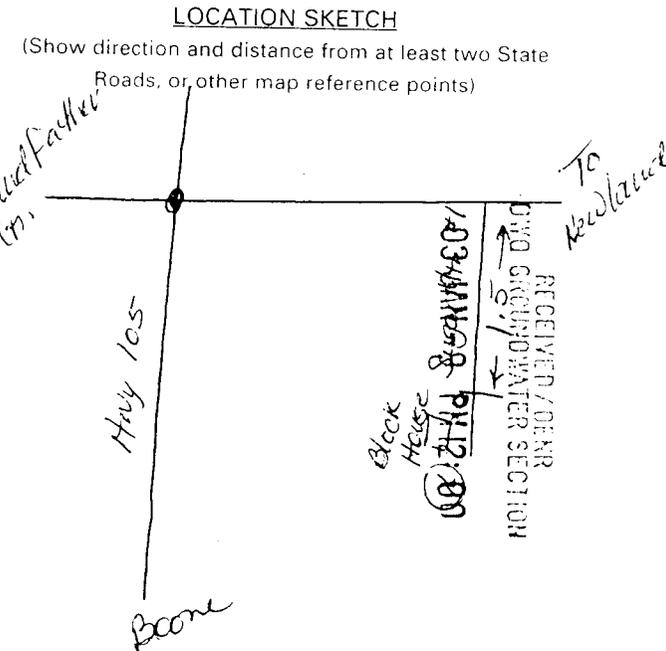

Steve Petty 1-3-03
 SIGNATURE OF PERSON CONSTRUCTING THE WELL DATE

FOR OFFICE USE ONLY
 Quad No: _____
 Serial No. _____