

266938

# WELL CONSTRUCTION RECORD

020927

WELL CONTRACTOR: Dewey Wright Well Pump Co., Inc.  
 WELL CONTRACTOR CERTIFICATION #: 2681  
 STATE WELL CONSTRUCTION PERMIT#: Steve Falty

1. WELL USE (Check Applicable Box): Residential  Municipal  Industrial  Agricultural  Monitoring   
 Recovery  Heat Pump Water Injection  Other  If Other, List Use: \_\_\_\_\_

2. WELL LOCATION: (Show sketch of the location below)  
 Nearest Town: INVERSHIELD County: AVERY  
DOBBINS RD. OFF HWY 184  
(Road Name and Numbers, Community, or Subdivision and Lot No.)

3. \_\_\_\_\_  
 4. DATE DRILLED 11/13/2002  
 5. TOTAL DEPTH 740  
 6. CUTTINGS COLLECTED YES  NO   
 7. DOES WELL REPLACE EXISTING WELL? YES  NO   
 8. STATIC WATER LEVEL Below Top of Casing: 180 FT.  
(Use "+" if Above Top of Casing)

DRILLING LOG		DEPTH
From	To	Formation Description
0	81	DIRT
81	200	GRANITE
200	203	QUARTZ
203	580	GRANITE
580	585	QUARTZ
585	740	GRANITE


If additional space is needed use back of form

9. TOP OF CASING IS 1 FT. Above Land Surface\*  
\*Top of casing terminated at/or below land surface requires a variance in accordance with 15A NCAC 2C.0118  
 10. YIELD (gpm): 15 METHOD OF TEST Air  
2 gpm 200-203 13 gpm 580-585  
 11. WATER ZONES (depth): 0 gpm 0 gpm  
 12. CHLORINATION: Type HTH Amount 114

13. CASING:  

From	Depth	To	Diameter	Wall Thickness or Weight/Ft.	Material
0		114 Ft.	6 1/8	.188	GALV
_____		_____ Ft.	_____	_____	_____
_____		_____ Ft.	_____	_____	_____

LOCATION SKETCH  
 (Show direction and distance from at least two State Roads, or other map reference points)

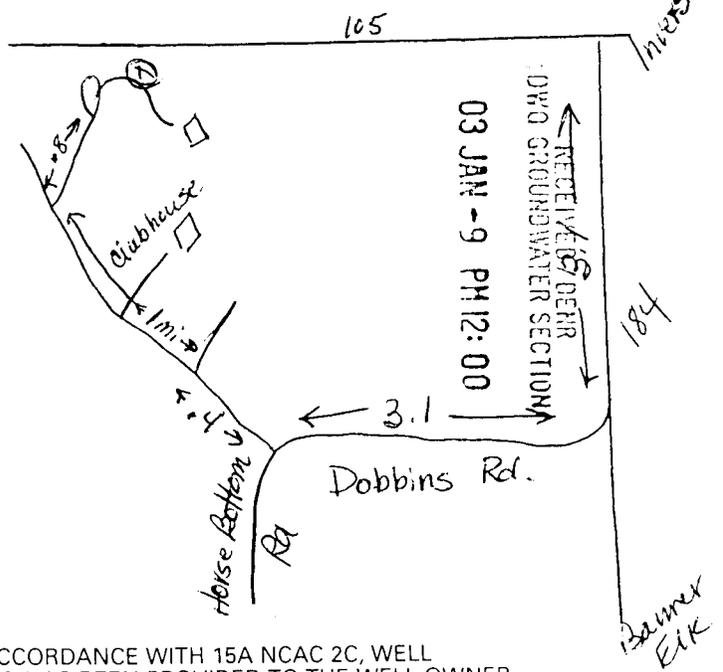

14. GROUT:  

From	Depth	To	Material	Method
0		20 Ft.	Cement	Gravity Flow
_____		_____ Ft.	_____	_____

15. SCREEN:  

From	Depth	To	Diameter	Slot Size	Material
_____		_____ Ft.	_____ in.	_____ in.	_____
_____		_____ Ft.	_____ in.	_____ in.	_____
_____		_____ Ft.	_____ in.	_____ in.	_____

16. SAND/GRAVEL PACK:  

From	Depth	To	Size	Material
_____		_____ Ft.	_____	_____
_____		_____ Ft.	_____	_____

17. REMARKS: I DO HEREBY CERTIFY THAT THIS WELL WAS CONSTRUCTED IN ACCORDANCE WITH 15A NCAC 2C, WELL CONSTRUCTION STANDARDS, AND THAT A COPY OF THIS RECORD HAS BEEN PROVIDED TO THE WELL OWNER.

FOR OFFICE USE ONLY

Quad No: \_\_\_\_\_  
 Serial No: \_\_\_\_\_

SIGNATURE OF PERSON CONSTRUCTING THE WELL  
Submit original to Division of Water Quality, Groundwater Section within 30 days

DATE  
 GW-1 REV. 12/99