

268014

# WELL CONSTRUCTION RECORD

020145

WELL CONTRACTOR: Dewey Wright Well Pump Co., Inc.  
 WELL CONTRACTOR CERTIFICATION #: 2881  
 STATE WELL CONSTRUCTION PERMIT#: Steve Petty

1. WELL USE (Check Applicable Box): Residential  Municipal  Industrial  Agricultural  Monitoring   
 Recovery  Heat Pump Water Injection  Other  If Other, List Use: \_\_\_\_\_

2. WELL LOCATION: (Show sketch of the location below)  
 Nearest Town: BOONE County: AVERY  
PRIVATE RD. OFF FLAT SPRS CEM RD. OFF FLAT SPR  
(Road Name and Numbers, Community, or Subdivision and Lot No.)

3. DATE DRILLED 12/31/2002  
 4. TOTAL DEPTH 105  
 5. CUTTINGS COLLECTED YES  NO   
 6. DOES WELL REPLACE EXISTING WELL? YES  NO   
 7. STATIC WATER LEVEL Below Top of Casing: 5 FT.  
(Use "+" if Above Top of Casing)


DRILLING LOG		DEPTH
From	To	Formation Description
0	35	DIRT
35	50	GRANITE
50	52	SHALE
52	82	GRANITE
82	84	SHALE
84	105	GRANITE

If additional space is needed use back of form

9. TOP OF CASING IS 1 FT. Above Land Surface\*  
\*Top of casing terminated at/or below land surface requires a variance in accordance with 15A NCAC 2C.0118  
 10. YIELD (gpm): 12 METHOD OF TEST Air  
 11. WATER ZONES (depth): 5 gpm 50-52 7 gpm 82-84  
gpm 0 gpm  
 12. CHLORINATION: Type HTH Amount 21

13. CASING:

Depth	Diameter	Wall Thickness or Weight/Ft.	Material
From <u>0</u> To <u>40</u> Ft.	<u>6 1/8</u>	<u>.350</u>	<u>PVC</u>
From _____ To _____ Ft.	_____	_____	_____
From _____ To _____ Ft.	_____	_____	_____

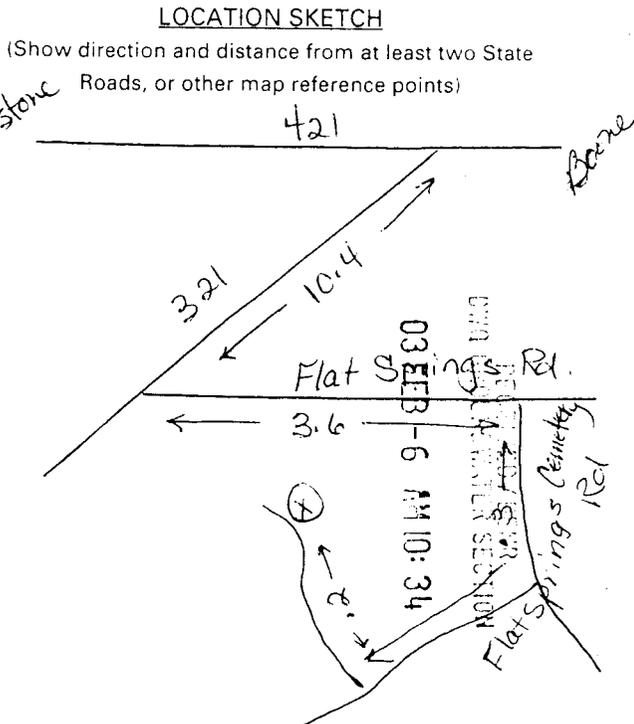

14. GROUT:

Depth	Material	Method
From <u>0</u> To <u>20</u> Ft.	<u>Cement</u>	<u>Gravity Flow</u>
From _____ To _____ Ft.	_____	_____

15. SCREEN:

Depth	Diameter	Slot Size	Material
From _____ To _____ Ft.	_____ in.	_____ in.	_____
From _____ To _____ Ft.	_____ in.	_____ in.	_____
From _____ To _____ Ft.	_____ in.	_____ in.	_____

16. SAND/GRAVEL PACK:

Depth	Size	Material
From _____ To _____ Ft.	_____	_____
From _____ To _____ Ft.	_____	_____

17. REMARKS:  
 I DO HEREBY CERTIFY THAT THIS WELL WAS CONSTRUCTED IN ACCORDANCE WITH 15A NCAC 2C, WELL CONSTRUCTION STANDARDS, AND THAT A COPY OF THIS RECORD HAS BEEN PROVIDED TO THE WELL OWNER.

**FOR OFFICE USE ONLY**  
 Quad No: \_\_\_\_\_  
 Serial No: \_\_\_\_\_

*Steve Petty*  
 SIGNATURE OF PERSON CONSTRUCTING THE WELL  
 Submit original to Division of Water Quality, Groundwater Section within 30 days

DATE 1-30-03  
 GW-1 REV. 12/99