

WELL CONSTRUCTION RECORD

271155

North Carolina - Department of Environment and Natural Resources - Division of Water Quality - Groundwater Section

WELL CONTRACTOR (INDIVIDUAL) NAME (print) Kenneth Jordan CERTIFICATION # 2669
 WELL CONTRACTOR COMPANY NAME Braswell Well Drilling PHONE # (86) 733-2600
 STATE WELL CONSTRUCTION PERMIT# _____ ASSOCIATED WQ PERMIT# _____
 (if applicable) (if applicable)

1. WELL USE (Check Applicable Box): Residential Municipal/Public Industrial Agricultural
 Monitoring Recovery Heat Pump Water Injection Other If Other, List Use private

2. WELL LOCATION:
 Nearest Town: BRANNO ELK County AUGUSTA
484 Old Beechmont Rd John Jones Rd.
 (Street Name, Numbers, Community, Subdivision, Lot No., Zip Code)

Topographic/Land setting
 Ridge Slope Valley Flat
 (check appropriate box)
 Latitude/longitude of well location

3. (degrees/minutes/seconds)
 Latitude/longitude source: GPS Topographic map
 (check box)

Area code- Phone number _____
 4. DATE DRILLED 8-2-02
 5. TOTAL DEPTH: 580
 6. DOES WELL REPLACE EXISTING WELL? YES NO
 7. STATIC WATER LEVEL Below Top of Casing: 120 FT.
 (Use "+" if Above Top of Casing)
 8. TOP OF CASING IS L FT. Above Land Surface*
 *Top of casing terminated at/or below land surface requires a variance in accordance with 15A NCAC 2C .0118.
 9. YIELD (gpm): 1.5 METHOD OF TEST Air
 10. WATER ZONES (depth): 975-480 ft gal

DEPTH		DRILLING LOG
From	To	Formation Description
<u>0</u>	<u>3</u>	<u>reddish</u>
<u>3</u>	<u>375</u>	<u>granite, pink slate</u>
		<u>gray slate</u>
<u>375</u>	<u>400</u>	<u>brown slate</u>
<u>400</u>	<u>530</u>	<u>granite, pink gray</u>
		<u>slate</u>


11. DISINFECTION Type HTH Amount 5.02
 12. CASING:

From	To	Depth	Diameter	Wall Thickness	Material
		Ft.	Ft.	or Weight/Ft.	
<u>-1</u>	<u>20</u>		<u>6.75</u>	<u>187</u>	<u>galv</u>
From _____	To _____	Ft. _____	Ft. _____	_____	_____
From _____	To _____	Ft. _____	Ft. _____	_____	_____

From	To	Depth	Material	Method
		Ft.		
<u>0</u>	<u>20</u>		<u>concrete</u>	<u>pourcast</u>
From _____	To _____	Ft. _____	_____	_____
From _____	To _____	Ft. _____	_____	_____

From	To	Depth	Diameter	Slot Size	Material
		Ft.	in.	in.	
From _____	To _____	Ft. _____	in. _____	in. _____	_____
From _____	To _____	Ft. _____	in. _____	in. _____	_____

From	To	Depth	Size	Material
		Ft.		
From _____	To _____	Ft. _____	_____	_____
From _____	To _____	Ft. _____	_____	_____

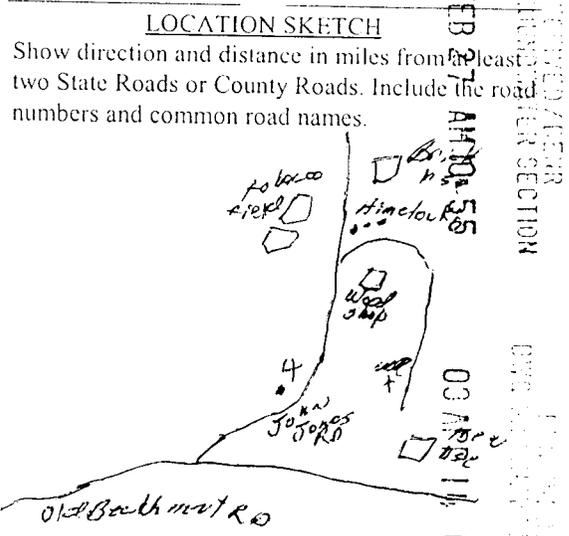

DIVISION OF WATER QUALITY
 GROUNDWATER SECTION
 03 FEB 2003
 03 MAR 2003
 03 APR 2003
 03 MAY 2003
 03 JUN 2003
 03 JUL 2003
 03 AUG 2003
 03 SEP 2003
 03 OCT 2003
 03 NOV 2003
 03 DEC 2003

16. REMARKS: _____

I DO HEREBY CERTIFY THAT THIS WELL WAS CONSTRUCTED IN ACCORDANCE WITH 15A NCAC 2C, WELL CONSTRUCTION STANDARDS, AND THAT A COPY OF THIS RECORD HAS BEEN PROVIDED TO THE WELL OWNER


 SIGNATURE OF PERSON CONSTRUCTING THE WELL

8-2-02
 DATE