

226532

WELL CONSTRUCTION RECORD

WELL CONTRACTOR: BRASWELL Well Drilling
 WELL CONTRACTOR CERTIFICATION #: 2133, 2669
 STATE WELL CONSTRUCTION PERMIT#: _____

1. WELL USE (Check Applicable Box): Residential Municipal Industrial Agricultural Monitoring
 Recovery Heat Pump Water Injection Other If Other, List Use: private

2. WELL LOCATION (Show sketch of the location below)
 Nearest Town: Plumtree County: Alamogordo

3. (Road Name and Numbers, Community, or Subdivision and Lot No.)
Terrace Court

4. DATE DRILLED 1-24-01
 5. TOTAL DEPTH 160
 6. CUTTINGS COLLECTED YES NO
 7. DOES WELL REPLACE EXISTING WELL? YES NO
 8. STATIC WATER LEVEL Below Top of Casing: 40 FT.
 9. TOP OF CASING IS 4 FT. Above Land Surface*
*Top of casing terminated at/ or below land surface requires a variance in accordance with 15A NCAC 2C .0118

DRILLING LOG		DEPTH
From	To	Formation Description
0 - 64		red dirt gravel border
64 - 70		gravel
70 - 73		shale
73 - 119		granite
119 - 121		shale
121 - 160		granite

DINO HANCOCK WATER SECTION
 FEB 19 PM 1:30
 01

10. YIELD (gpm): 10 METHOD OF TEST Air
 11. WATER ZONES (depth):
70-77 29 gal
119-121 29 gal
 12. CHLORINATION: Type HTH Amount 300
 13. CASING:

From	To	Depth	Diameter	Wall Thickness or Weight	Material
-1	64	Ft.	6-3/4	180	Galv
_____	_____	Ft.	_____	_____	_____
_____	_____	Ft.	_____	_____	_____

14. GROUT:

From	To	Depth	Material	Method
0	40	Ft.	concrete	pour
_____	_____	Ft.	_____	_____

15. SCREEN:


From	To	Depth	Diameter	Slot Size	Material
_____	_____	Ft.	_____ in.	_____ in.	_____
_____	_____	Ft.	_____ in.	_____ in.	_____
_____	_____	Ft.	_____ in.	_____ in.	_____

16. SAND/GRAVEL PACK:

From	To	Depth	Size	Material
_____	_____	Ft.	_____	_____
_____	_____	Ft.	_____	_____

17. REMARKS: _____

LOCATION SKETCH
 (Show direction and distance from at least two State Roads, or other map reference points)

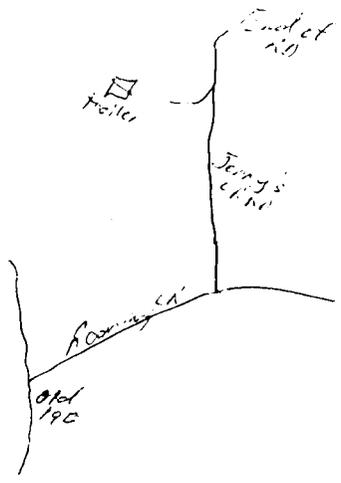

I DO HEREBY CERTIFY THAT THIS WELL WAS CONSTRUCTED IN ACCORDANCE WITH 15A NCAC 2C, WELL CONSTRUCTION STANDARDS, AND THAT A COPY OF THIS RECORD HAS BEEN PROVIDED TO THE WELL OWNER.

FOR OFFICE USE ONLY
 Quad No: _____
 Serial No. _____

SIGNATURE OF PERSON CONSTRUCTING THE WELL: [Signature] DATE: 1-24-2001
 Submit original to Division of Water Quality, Groundwater Section within 30 days