

226736

WELL CONSTRUCTION RECORD

WELL CONTRACTOR: Dewey Wright Well Pump Co., Inc.
 WELL CONTRACTOR CERTIFICATION #: 2686
 STATE WELL CONSTRUCTION PERMIT#: Leslie Reece

010097

1. WELL USE (Check Applicable Box): Residential Municipal Industrial Agricultural Monitoring
 Recovery Heat Pump Water Injection Other If Other, List Use: _____

2. WELL LOCATION: (Show sketch of the location below)
 Nearest Town: ELK PARK County: AVERY
BUCK MTN RD OFF HWY 19E
(Road Name and Numbers, Community, or Subdivision and Lot No.)


3. DATE DRILLED 2/12/2001
 4. TOTAL DEPTH 305
 5. CUTTINGS COLLECTED YES NO
 6. DOES WELL REPLACE EXISTING WELL? YES NO
 7. STATIC WATER LEVEL Below Top of Casing: 20 FT.
(Use "+" if Above Top of Casing)

DRILLING LOG		DEPTH
From	To	Formation Description
0	33	DIRT
33	86	GRANITE
86	87	QUARTZ
87	305	GRANITE

REC'D
DIV. OF GROUNDWATER SECTION
01 MAR - 2 PM 2001

8. TOP OF CASING IS 1 FT. Above Land Surface*
*Top of casing terminated at/or below land surface requires a variance in accordance with 15A NCAC 2C.0118
 9. YIELD (gpm): 1 METHOD OF TEST Air
 10. WATER ZONES (depth): 1 gpm 86-87 0 gpm
0 gpm 0 gpm
 11. CHLORINATION: Type HTH Amount 58

LOCATION SKETCH
 (Show direction and distance from at least two State Roads, or other map reference points)

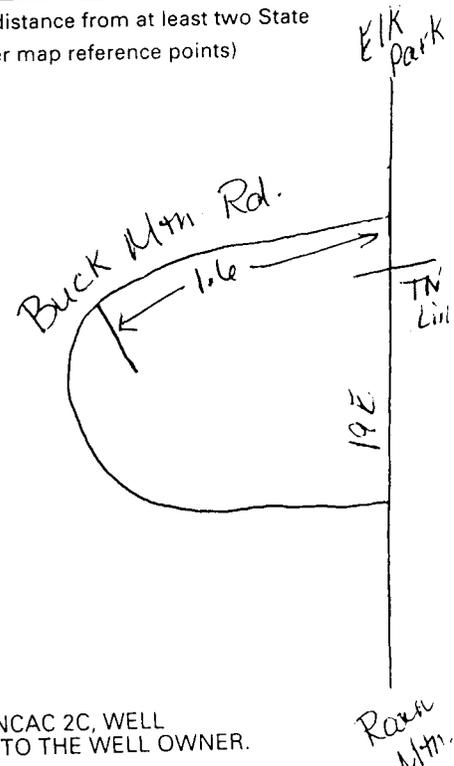

12. CASING:

From	To	Depth	Diameter	Wall Thickness or Weight/Ft.	Material
0	36	Ft.	6 1/8	350	PVC
36	_____	Ft.	_____	_____	_____
_____	_____	Ft.	_____	_____	_____

13. GROUT:

From	To	Depth	Material	Method
0	20	Ft.	Cement	Gravity Flow
20	_____	Ft.	_____	_____

14. SCREEN:

From	To	Depth	Diameter	Slot Size	Material
_____	_____	Ft.	_____ in.	_____ in.	_____
_____	_____	Ft.	_____ in.	_____ in.	_____
_____	_____	Ft.	_____ in.	_____ in.	_____

15. SAND/GRAVEL PACK:

From	To	Depth	Size	Material
_____	_____	Ft.	_____	_____
_____	_____	Ft.	_____	_____

16. REMARKS: _____
 I DO HEREBY CERTIFY THAT THIS WELL WAS CONSTRUCTED IN ACCORDANCE WITH 15A NCAC 2C, WELL CONSTRUCTION STANDARDS, AND THAT A COPY OF THIS RECORD HAS BEEN PROVIDED TO THE WELL OWNER.
Leslie Wayne Reece 2-27-01
 SIGNATURE OF PERSON CONSTRUCTING THE WELL DATE

FOR OFFICE USE ONLY
 Quad No: _____
 Serial No: _____