

226774

**WELL CONSTRUCTION RECORD**

WELL CONTRACTOR: Dewey Wright Well Pump Co., Inc.  
 WELL CONTRACTOR CERTIFICATION #: 2686  
 STATE WELL CONSTRUCTION PERMIT#: Leslie Reece

010102

1. WELL USE (Check Applicable Box): Residential  Municipal  Industrial  Agricultural  Monitoring   
 Recovery  Heat Pump Water Injection  Other  If Other, List Use: \_\_\_\_\_

2. WELL LOCATION: (Show sketch of the location below)  
 Nearest Town: BANNER ELK County: AVERY  
SANFORD PL. LN. OFF JOE PARLIER RD. OFF OLD BEE  
(Road Name and Numbers, Community, or Subdivision and Lot No.)

DRILLING LOG		DEPTH
From	To	Formation Description
0	105	DIRT
105	591	GRANITE
591	592	SHALE
592	620	GRANITE

3. DATE DRILLED 2/7/2001  
 4. TOTAL DEPTH 620  
 5. CUTTINGS COLLECTED YES  NO   
 6. DOES WELL REPLACE EXISTING WELL? YES  NO   
 7. STATIC WATER LEVEL Below Top of Casing: 280 FT.  
(Use "+" if Above Top of Casing)

8. TOP OF CASING IS 1 FT. Above Land Surface\*  
\*Top of casing terminated at or below land surface requires a variance in accordance with 15A NCAC 2C.0118  
 9. YIELD (gpm): 5 METHOD OF TEST Air  
 10. WATER ZONES (depth): 5 gpm 591-592 0 gpm  
0 gpm 0 gpm  
 11. CHLORINATION: Type: HTH Amount: 69

12. CASING:

From	Depth	To	Diameter	Wall Thickness or Weight/Ft.	Material
0		111 Ft.	6 1/8"	.350	PVC
From		To	Ft.		
From		To	Ft.		

13. GROUT:

From	Depth	To	Material	Method
0		20 Ft.	Cement	Gravity Flow
From		To	Ft.	

14. SCREEN:


From	Depth	To	Diameter	Slot Size	Material
From		To	Ft.	in.	in.
From		To	Ft.	in.	in.
From		To	Ft.	in.	in.

15. SAND/GRAVEL PACK:

From	Depth	To	Size	Material
From		To	Ft.	
From		To	Ft.	

16. REMARKS:

LOCATION SKETCH  
 (Show direction and distance from at least two State Roads, or other map reference points)

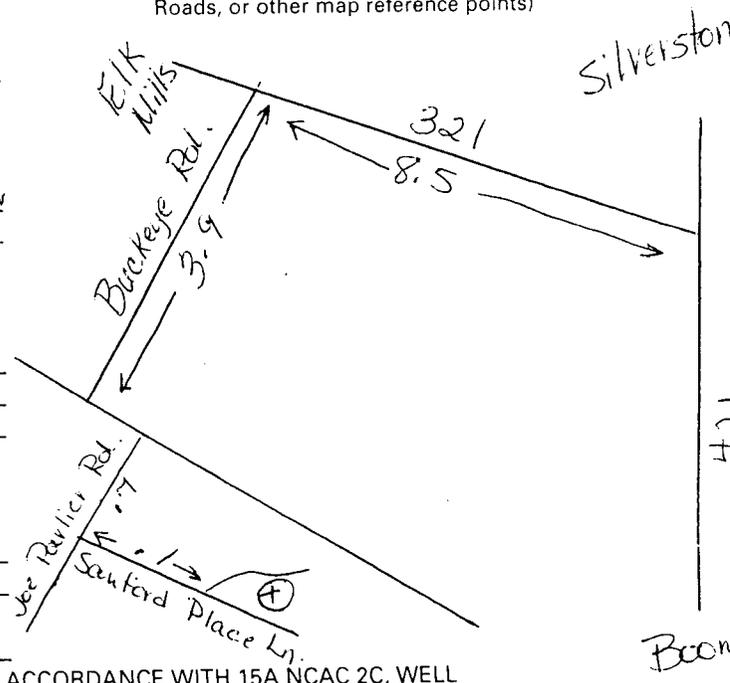

I DO HEREBY CERTIFY THAT THIS WELL WAS CONSTRUCTED IN ACCORDANCE WITH 15A NCAC 2C, WELL CONSTRUCTION STANDARDS, AND THAT A COPY OF THIS RECORD HAS BEEN PROVIDED TO THE WELL OWNER.

FOR OFFICE USE ONLY  
 Quad No: \_\_\_\_\_  
 Serial No: \_\_\_\_\_  
 Groundwater Section  
 Avera Regional Office

Leslie Wayne Reece  
 SIGNATURE OF PERSON CONSTRUCTING THE WELL  
 Submit original to Division of Water Quality, Groundwater Section within 30 days

2-27-01  
 DATE  
 GW-1 REV. 12/99