

229899

WELL CONSTRUCTION RECORD

WELL CONTRACTOR: Dewey Wright Well Pump Co., Inc.
 WELL CONTRACTOR CERTIFICATION #: 2686
 STATE WELL CONSTRUCTION PERMIT#: Leslie Reece

000486

1. WELL USE (Check Applicable Box): Residential Municipal Industrial Agricultural Monitoring
 Recovery Heat Pump Water Injection Other If Other, List Use: _____

2. WELL LOCATION: (Show sketch of the location below)
 Nearest Town: LINVILLE County: AVERY
PRIVATE DR. OFF BEAR CREEK RD. OFF MTN. SPRS. R
(Road Name and Numbers, Community, or Subdivision and Lot No.)

3. DRILLING LOG

From	To	Formation Description
0	21	DIRT
21	75	GRANITE
75	78	SHALE
78	205	GRANITE

4. DATE DRILLED 3/27/2001
 5. TOTAL DEPTH 205
 6. CUTTINGS COLLECTED YES NO
 7. DOES WELL REPLACE EXISTING WELL? YES NO
 8. STATIC WATER LEVEL Below Top of Casing: 40 FT.
(Use "+" if Above Top of Casing)

9. TOP OF CASING IS 1 FT. Above Land Surface*
*Top of casing terminated at/or below land surface requires a variance in accordance with 15A NCAC 2C.0118
 10. YIELD (gpm): 8 METHOD OF TEST Air
 11. WATER ZONES (depth): 8 gpm 75-78 0 gpm
0 gpm 0 gpm
 12. CHLORINATION: Type HTH Amount 35

13. CASING:

Depth	Diameter	Wall Thickness or Weight/Ft.	Material
From <u>0</u> To <u>24</u> Ft.	<u>6 1/4</u>	<u>188</u>	<u>GALV.</u>
From _____ To _____ Ft.	_____	_____	_____
From _____ To _____ Ft.	_____	_____	_____

14. GROUT:

Depth	Material	Method
From <u>0</u> To <u>20</u> Ft.	<u>Cement</u>	<u>Gravity Flow</u>
From _____ To _____ Ft.	_____	_____

15. SCREEN:

Depth	Diameter	Slot Size	Material
From _____ To _____ Ft.	_____ in.	_____ in.	_____
From _____ To _____ Ft.	_____ in.	_____ in.	_____
From _____ To _____ Ft.	_____ in.	_____ in.	_____

16. SAND/GRAVEL PACK:


Depth	Size	Material
From _____ To _____ Ft.	_____	_____
From _____ To _____ Ft.	_____	_____

17. REMARKS: _____

DRILLING LOG

From	To	Formation Description
0	21	DIRT
21	75	GRANITE
75	78	SHALE
78	205	GRANITE

RECEIVED/IDENR
 DWD GROUNDWATER SECTION
 01 APR 26 PM 2:23
 If additional space is needed use back of form

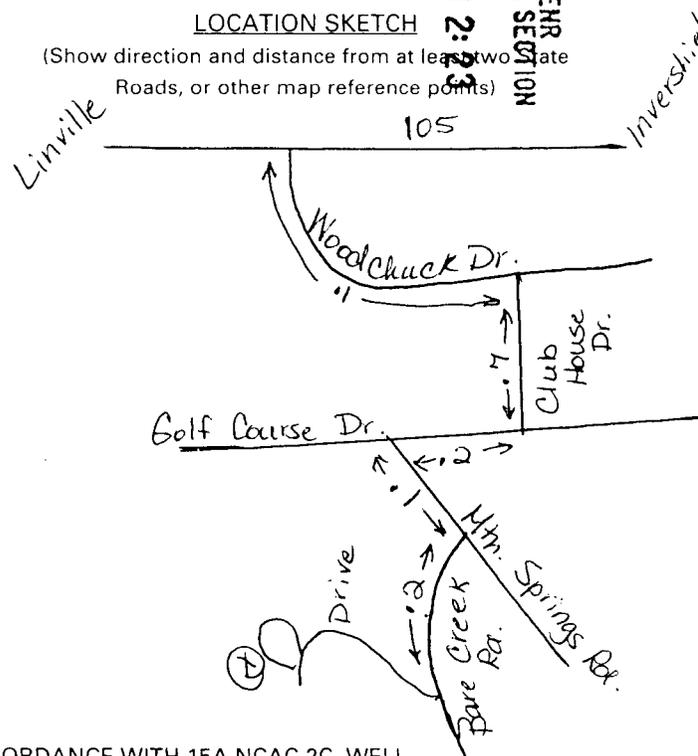

I DO HEREBY CERTIFY THAT THIS WELL WAS CONSTRUCTED IN ACCORDANCE WITH 15A NCAC 2C, WELL CONSTRUCTION STANDARDS, AND THAT A COPY OF THIS RECORD HAS BEEN PROVIDED TO THE WELL OWNER.

Leslie Wayne Reece

4-18-01

FOR OFFICE USE ONLY
 Quad No: _____
 Serial No: _____

SIGNATURE OF PERSON CONSTRUCTING THE WELL
 Submit original to Division of Water Quality, Groundwater Section within 30 days

DATE
 GW-1 REV. 12/99