

243824

WELL CONSTRUCTION RECORD

WELL CONTRACTOR: BRASWELL Well Drilling
 WELL CONTRACTOR CERTIFICATION #: 2133
 STATE WELL CONSTRUCTION PERMIT #: _____

1. WELL USE (Check Applicable Box): Residential Municipal Industrial Agricultural Monitoring
 Recovery Heat Pump Water Injection Other If Other, List Use: CHURCH

2. WELL LOCATION: (Show sketch of the location below)
 Nearest Town: Fingalls - Spruce Pine County: AVERY
Bent Rd.

(Road Name and Numbers, Community, or Subdivision and Lot No.)

DRILLING LOG

DEPTH

From To Formation Description

0 - 48 dirt
48 - 420 mica schists, granite

3. DATE DRILLED 5-31-01
 4. TOTAL DEPTH 420 ft.
 6. CUTTINGS COLLECTED YES NO
 7. DOES WELL REPLACE EXISTING WELL? YES NO
 8. STATIC WATER LEVEL Below Top of Casing: _____ FT.
 (Use "+" if Above Top of Casing)
 9. TOP OF CASING IS 1 FT. Above Land Surface*

*Top of casing terminated at/or below land surface requires a variance in accordance with 15A NCAC 2C .0118

10. YIELD (gpm): 50 METHOD OF TEST AIR Blown

11. WATER ZONES (depth): 375 ft.

12. CHLORINATION: Type chlorine Amount 3 oz.


13. CASING:

If additional space is needed use back of form

RECEIVED BY DENR DIVISION OF WATER SECTION 01 DEC 10 PM 3:10

LOCATION SKETCH

(Show direction and distance from at least two State Roads, or other map reference points)

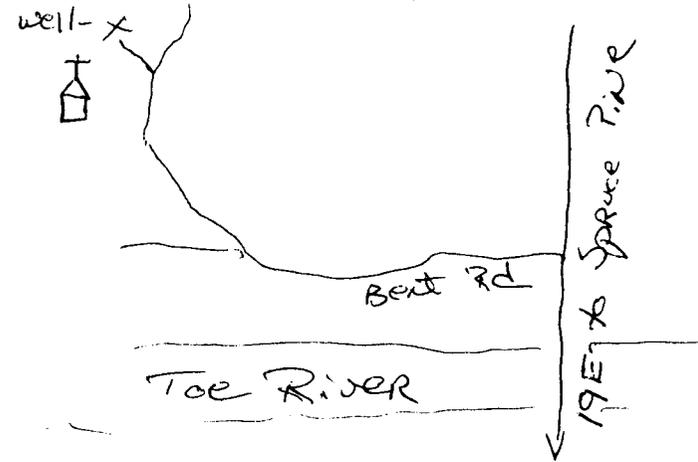

From	To	Depth	Diameter	Wall Thickness or Weight/Ft.	Material
0	53	ft.	6 1/4	sch. 80	PVC
_____	_____	ft.	_____	_____	_____
_____	_____	ft.	_____	_____	_____

14. GROUT:

From	To	Depth	Material	Method
0	20	ft.	cement	grouted
_____	_____	ft.	_____	_____

15. SCREEN:

From	To	Depth	Diameter	Slot Size	Material
_____	_____	ft.	_____ in.	_____ in.	_____
_____	_____	ft.	_____ in.	_____ in.	_____
_____	_____	ft.	_____ in.	_____ in.	_____

16. SAND/GRAVEL PACK:

From	To	Depth	Size	Material
_____	_____	ft.	_____	_____
_____	_____	ft.	_____	_____

17. REMARKS: _____

I DO HEREBY CERTIFY THAT THIS WELL WAS CONSTRUCTED IN ACCORDANCE WITH 15A NCAC 2C, WELL CONSTRUCTION STANDARDS, AND THAT A COPY OF THIS RECORD HAS BEEN PROVIDED TO THE WELL OWNER.

FOR OFFICE USE ONLY
 Quad No: _____
 Serial No: _____

SIGNATURE OF PERSON CONSTRUCTING THE WELL: [Signature]
 Submit original to Division of Water Quality, Groundwater Section within 30 days

DATE: 5-31-01