

255160

WELL CONSTRUCTION RECORD

WELL CONTRACTOR: Dewey Wright Well Pump Co., Inc.
 WELL CONTRACTOR CERTIFICATION #: 2797
 STATE WELL CONSTRUCTION PERMIT#: Jerry Wilson

020330

1. WELL USE (Check Applicable Box): Residential Municipal Industrial Agricultural Monitoring
 Recovery Heat Pump Water Injection Other If Other, List Use: _____

2. WELL LOCATION: (Show sketch of the location below)
 Nearest Town: LINVILLE County: AVERY
HAAS HARTLEY RD. OFF WEST FORK RD. OFF JOE HAR
(Road Name and Numbers, Community, or Subdivision and Lot No.)

DRILLING LOG		DEPTH
From	To	Formation Description
0	73	DIRT
73	180	GRANITE
180	181	GRANITE
181	370	GRANITE
370	371	GRANITE
371	405	GRANITE

3.

4. DATE DRILLED 8/12/2002
 5. TOTAL DEPTH 405
 6. CUTTINGS COLLECTED YES NO
 7. DOES WELL REPLACE EXISTING WELL? YES NO
 8. STATIC WATER LEVEL Below Top of Casing: 50 FT.
(Use "+" if Above Top of Casing)


9. TOP OF CASING IS 1 FT. Above Land Surface*
*Top of casing terminated at/or below land surface requires a variance in accordance with 15A NCAC 2C.0118
 10. YIELD (gpm): 1.5 METHOD OF TEST Air
 11. WATER ZONES (depth): 5 gpm 180-181 1 gpm 370-371
0 gpm 0 gpm
 12. CHLORINATION: Type HTH Amount 71

If additional space is needed use back of form

13. CASING:

From	Depth	To	Diameter	Wall Thickness or Weight/Ft.	Material
0		84	6 1/4	.188	GALV.
From	To	Ft.			
From	To	Ft.			

LOCATION SKETCH
 (Show direction and distance from at least two State Roads, or other map reference points)

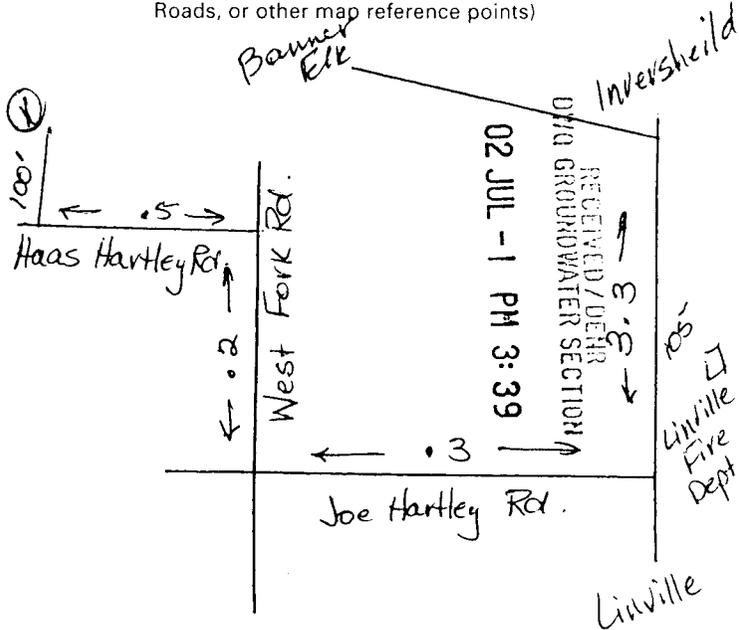

14. GROUT:

From	Depth	To	Material	Method
0		20	Cement	Gravity Flow
From	To	Ft.		
From	To	Ft.		

15. SCREEN:

From	Depth	To	Diameter	Slot Size	Material
From	To	Ft.	in.	in.	
From	To	Ft.	in.	in.	
From	To	Ft.	in.	in.	

16. SAND/GRAVEL PACK:

From	Depth	To	Size	Material
From	To	Ft.		
From	To	Ft.		

17. REMARKS: RECEIVED
 I DO HEREBY CERTIFY THAT THIS WELL WAS CONSTRUCTED IN ACCORDANCE WITH 15A NCAC 2C, WELL CONSTRUCTION STANDARDS, AND THAT A COPY OF THIS RECORD HAS BEEN PROVIDED TO THE WELL OWNER.
Jerry Wilson 6-28-2002

FOR OFFICE USE ONLY
 Quad No: _____
 Serial No. _____

SIGNATURE OF PERSON CONSTRUCTING THE WELL _____ DATE _____
 Submit original to Division of Water Quality, Groundwater Section within 30 days
 GW-1 REV. 12/99