

268027

# WELL CONSTRUCTION RECORD

WELL CONTRACTOR: Dewey Wright Well Pump Co., Inc.  
 WELL CONTRACTOR CERTIFICATION #: 2687  
 STATE WELL CONSTRUCTION PERMIT#: Steve Reece

021021

1. WELL USE (Check Applicable Box): Residential  Municipal  Industrial  Agricultural  Monitoring   
 Recovery  Heat Pump Water Injection  Other  If Other, List Use: \_\_\_\_\_

2. WELL LOCATION: (Show sketch of the location below)  
 Nearest Town: NEWLAND County: AVERY  
PRIVATE DR. OFF GEORGE WHITE RD. OFF CAMP CRE  
(Road Name and Numbers, Community, or Subdivision and Lot No.)

3. \_\_\_\_\_  
 4. DATE DRILLED 1/14/2003  
 5. TOTAL DEPTH 320  
 6. CUTTINGS COLLECTED YES  NO   
 7. DOES WELL REPLACE EXISTING WELL? YES  NO   
 8. STATIC WATER LEVEL Below Top of Casing: 80 FT.  
(Use "+" if Above Top of Casing)

DRILLING LOG		DEPTH
From	To	Formation Description
0	70	DIRT
70	240	GRANITE
240	243	QUARTZ
243	295	GRANITE
295	298	QUARTZ
298	320	GRANITE

If additional space is needed use back of form

9. TOP OF CASING IS 1 FT. Above Land Surface\*  
\*Top of casing terminated at/or below land surface requires a variance in accordance with 15A NCAC 2C.0114  
 10. YIELD (gpm): 50 METHOD OF TEST Air  
7 gpm 240-243 43 gpm 205-208  
 11. WATER ZONES (depth): 0 gpm 0 gpm  
 12. CHLORINATION: Type HTH Amount 4g

13. CASING:

From	Depth To	Diameter	Wall Thickness or Weight/Ft.	Material
0	76 Ft.	6 1/8	350	PVC
From	To	Ft.		
From	To	Ft.		

14. GROUT:

From	Depth To	Material	Method
0	20 Ft.	Cement	Gravity Flow
From	To	Ft.	


15. SCREEN:

From	Depth To	Diameter	Slot Size	Material
From	To	Ft.	in.	in.
From	To	Ft.	in.	in.
From	To	Ft.	in.	in.

16. SAND/GRAVEL PACK:

From	Depth To	Size	Material
From	To	Ft.	
From	To	Ft.	

17. REMARKS: \_\_\_\_\_  
 I DO HEREBY CERTIFY THAT THIS WELL WAS CONSTRUCTED IN ACCORDANCE WITH 15A NCAC 2C, WELL CONSTRUCTION STANDARDS, AND THAT A COPY OF THIS RECORD HAS BEEN PROVIDED TO THE WELL OWNER.

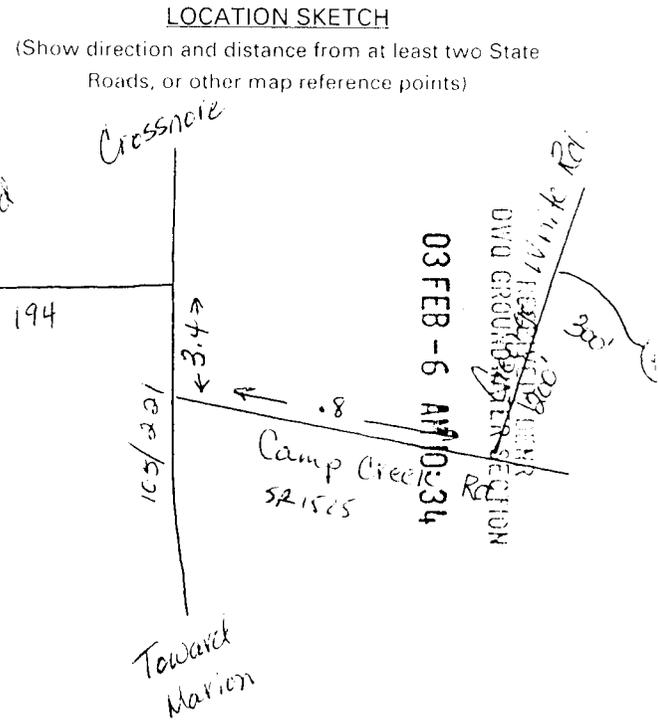

**FOR OFFICE USE ONLY**  
 Quad No: \_\_\_\_\_  
 Serial No. \_\_\_\_\_

Steve Reece 1-31-03  
 SIGNATURE OF PERSON CONSTRUCTING THE WELL DATE  
 Submit original to Division of Water Quality, Groundwater Section within 30 days  
 GW-1 REV. 12/99