

272297

WELL CONSTRUCTION RECORD

WELL CONTRACTOR: Dewey Wright Well Pump Co., Inc.
 WELL CONTRACTOR CERTIFICATION #: 2681
 STATE WELL CONSTRUCTION PERMIT#: Steve Petty

030059

1. WELL USE (Check Applicable Box): Residential Municipal Industrial Agricultural Monitoring
 Recovery Heat Pump Water Injection Other If Other, List Use: _____

2. WELL LOCATION: (Show sketch of the location below)
 Nearest Town: VILAS County: AVERY
STONE HOLLOW RD. OFF FLATSPRINGS RD OFF HWY
(Road Name and Numbers, Community, or Subdivision and Lot No.)

DRILLING LOG

DEPTH

From	To	Formation Description
0	40	DIRT GRAVEL
40	90	GRANITE
90	92	SHALE
92	115	GRANITE
115	118	SHALE
118	125	GRANITE

3. DATE DRILLED 3/11/2003
 4. TOTAL DEPTH 125
 5. CUTTINGS COLLECTED YES NO
 6. DOES WELL REPLACE EXISTING WELL? YES NO
 7. STATIC WATER LEVEL Below Top of Casing: 30 FT.
(Use "+" if Above Top of Casing)

9. TOP OF CASING IS 1 FT. Above Land Surface*
*Top of casing terminated at/or below land surface requires a variance in accordance with 15A NCAC 2C.0118
 10. YIELD (gpm): 30 METHOD OF TEST Air
 11. WATER ZONES (depth): 20 gpm 90-92 10 gpm 115-118
0 gpm 0 gpm
 12. CHLORINATION: Type HTH Amount 20

If additional space is needed use back of form

13. CASING:

From	Depth	To	Diameter	Wall Thickness or Weight/Ft.	Material
0	45	Ft.	6 1/8	.350	PVC
From	To	Ft.			
From	To	Ft.			

14. GROUT:

From	Depth	To	Material	Method
0	20	Ft.	Cement	Gravity Flow
From	To	Ft.		

15. SCREEN:

From	Depth	To	Diameter	Slot Size	Material
From	To	Ft.	in.	in.	
From	To	Ft.	in.	in.	
From	To	Ft.	in.	in.	


16. SAND/GRAVEL PACK:

From	Depth	To	Size	Material
From	To	Ft.		
From	To	Ft.		

17. REMARKS:
 I DO HEREBY CERTIFY THAT THIS WELL WAS CONSTRUCTED IN ACCORDANCE WITH 15A NCAC 2C, WELL CONSTRUCTION STANDARDS, AND THAT A COPY OF THIS RECORD HAS BEEN PROVIDED TO THE WELL OWNER.

LOCATION SKETCH

(Show direction and distance from at least two State Roads, or other map reference points)

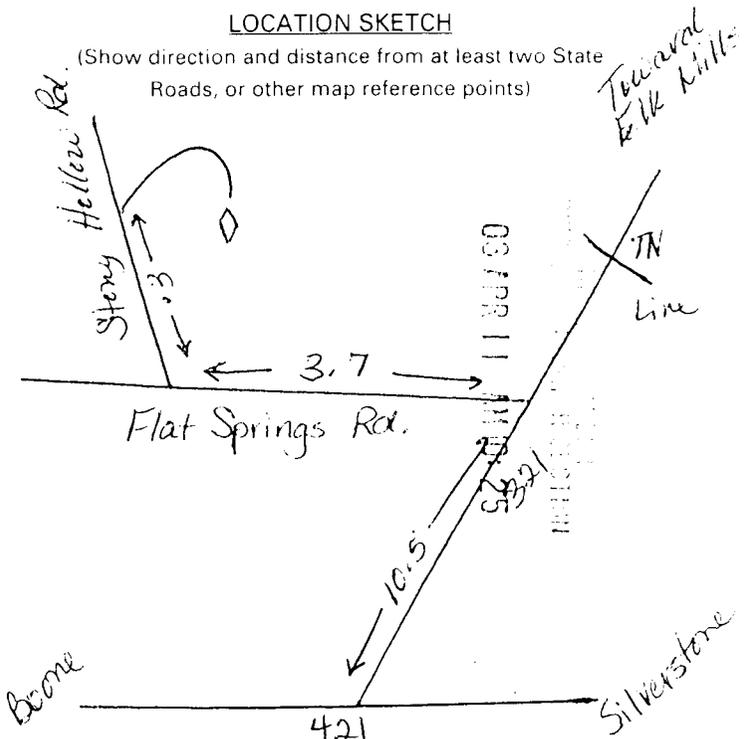

FOR OFFICE USE ONLY

Quad No: _____
 Serial No: _____

SIGNATURE OF PERSON CONSTRUCTING THE WELL
Submit original to Division of Water Quality, Groundwater Section within 30 days

DATE