

272298

WELL CONSTRUCTION RECORD

000300

WELL CONTRACTOR: Dewey Wright Well Pump Co., Inc.
 WELL CONTRACTOR CERTIFICATION #: 2681
 STATE WELL CONSTRUCTION PERMIT#: Steve Petty

1. WELL USE (Check Applicable Box): Residential Municipal Industrial Agricultural Monitoring
 Recovery Heat Pump Water Injection Other If Other, List Use: _____

2. WELL LOCATION: (Show sketch of the location below)
 Nearest Town: LINVILLE County: AVERY
HICKORY NUT GAP RD. OFF HWY 184 OFF HWY 105
(Road Name and Numbers, Community, or Subdivision and Lot No.)

3. _____
 4. DATE DRILLED 3/13/2003
 5. TOTAL DEPTH 145
 6. CUTTINGS COLLECTED YES NO
 7. DOES WELL REPLACE EXISTING WELL? YES NO
 8. STATIC WATER LEVEL Below Top of Casing: 20 FT.
(Use "+" if Above Top of Casing)

DRILLING LOG		DEPTH
From	To	Formation Description
0	85	DIRT
85	90	GRANITE
90	92	SHALE
92	130	GRANITE
130	135	SHALE
135	145	GRANITE

If additional space is needed use back of form

9. TOP OF CASING IS 1 FT. Above Land Surface*
*Top of casing terminated at/or below land surface requires a variance in accordance with 15A NCAC 2C.0118
 10. YIELD (gpm): 100 METHOD OF TEST Air
 11. WATER ZONES (depth): 2 gpm 90-92 99 gpm 130-135
0 gpm 0 gpm
 12. CHLORINATION: Type HTH Amount 26

13. CASING:

From	Depth	To	Diameter	Wall Thickness or Weight/Ft.	Material
0		73 Ft.	6 1/8	350	PVC
From	To	Ft.			
From	To	Ft.			

14. GROUT:

From	Depth	To	Material	Method
0		20 Ft.	Cement	Gravity Flow
From	To	Ft.		


15. SCREEN:

From	Depth	To	Ft.	Diameter	Slot Size	Material
From	To	Ft.				
From	To	Ft.				
From	To	Ft.				

16. SAND/GRAVEL PACK:

From	Depth	To	Ft.	Size	Material
From	To	Ft.			
From	To	Ft.			

17. REMARKS:
 I DO HEREBY CERTIFY THAT THIS WELL WAS CONSTRUCTED IN ACCORDANCE WITH 15A NCAC 2C, WELL CONSTRUCTION STANDARDS, AND THAT A COPY OF THIS RECORD HAS BEEN PROVIDED TO THE WELL OWNER.
Steve Petty 4-4-03
 SIGNATURE OF PERSON CONSTRUCTING THE WELL DATE

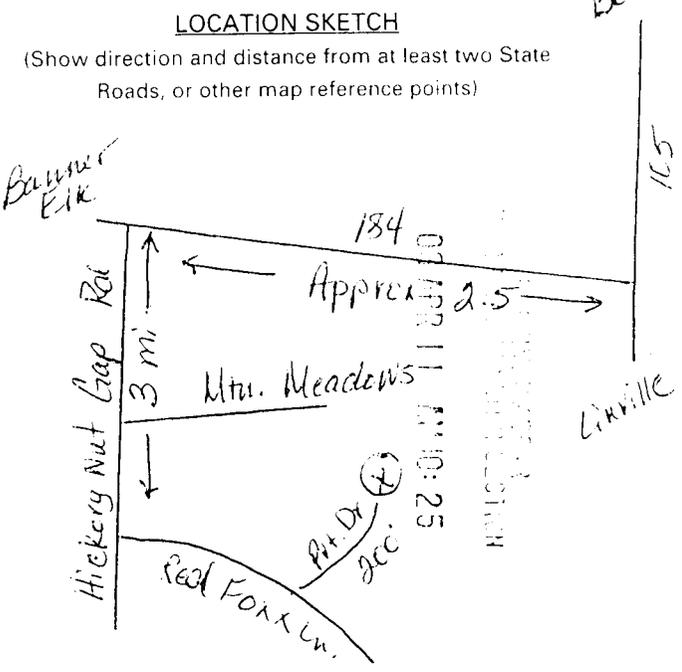

FOR OFFICE USE ONLY

Quad No: _____ Submit original to Division of Water Quality, Groundwater Section within 30 days

Serial No: _____