

272323

WELL CONSTRUCTION RECORD

WELL CONTRACTOR: Dewey Wright Well Pump Co., Inc.
 WELL CONTRACTOR CERTIFICATION #: 2687
 STATE WELL CONSTRUCTION PERMIT#: Steve Reece

020807

1. WELL USE (Check Applicable Box): Residential Municipal Industrial Agricultural Monitoring
 Recovery Heat Pump Water Injection Other If Other, List Use: _____

2. WELL LOCATION: (Show sketch of the location below)
 Nearest Town: BANNER ELK County: AVERY
MTN. MEADOWS OFF HICKORY NUT GAP RD. OFF HWY
(Road Name and Numbers, Community, or Subdivision and Lot No.)

3. DATE DRILLED 3/20/2003
 4. TOTAL DEPTH 600
 5. CUTTINGS COLLECTED YES NO
 6. DOES WELL REPLACE EXISTING WELL? YES NO
 7. STATIC WATER LEVEL Below Top of Casing: 50 FT.
(Use "+" if Above Top of Casing)

DRILLING LOG		DEPTH
From	To	Formation Description
0	32	DIRT
32	100	GRANITE
100	103	QUARTZ
103	540	GRANITE
540	544	QUARTZ
544	600	GRANITE


9. TOP OF CASING IS 1 FT. Above Land Surface*
*Top of casing terminated at/or below land surface requires a variance in accordance with 15A NCAC 2C.0118
 10. YIELD (gpm): 3 METHOD OF TEST Air
 11. WATER ZONES (depth): 5 gpm 100-103 2.5 gpm 540-544
0 gpm 0 gpm
 12. CHLORINATION: Type HTH Amount 113

If additional space is needed use back of form

13. CASING:
 From 0 To 37 Ft. Diameter 6 1/8 Wall Thickness or Weight/Ft. 350 Material PVC
 From _____ To _____ Ft. _____
 From _____ To _____ Ft. _____

LOCATION SKETCH
 (Show direction and distance from at least two State Roads, or other map reference points)

14. GROUT:
 From 0 To 20 Ft. Material Cement Method Gravity Flow
 From _____ To _____ Ft. _____

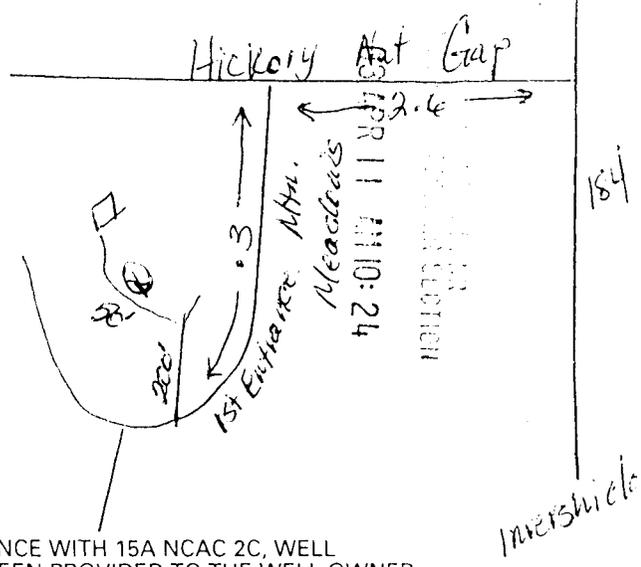

15. SCREEN:
 From _____ To _____ Ft. Diameter _____ in. Slot Size _____ in. Material _____
 From _____ To _____ Ft. _____ in. _____ in. _____
 From _____ To _____ Ft. _____ in. _____ in. _____

16. SAND/GRAVEL PACK:
 From _____ To _____ Ft. Size _____ Material _____
 From _____ To _____ Ft. _____

17. REMARKS:
 I DO HEREBY CERTIFY THAT THIS WELL WAS CONSTRUCTED IN ACCORDANCE WITH 15A NCAC 2C, WELL CONSTRUCTION STANDARDS, AND THAT A COPY OF THIS RECORD HAS BEEN PROVIDED TO THE WELL OWNER.

Steve Reece 4-4-03

SIGNATURE OF PERSON CONSTRUCTING THE WELL DATE
 Submit original to Division of Water Quality, Groundwater Section within 30 days

FOR OFFICE USE ONLY
 Quad No: _____
 Serial No: _____