

272326

**WELL CONSTRUCTION RECORD**

WELL CONTRACTOR: Dewey Wright Well Pump Co., Inc.  
 WELL CONTRACTOR CERTIFICATION #: 2887  
 STATE WELL CONSTRUCTION PERMIT#: Steve Reece

030083

1. WELL USE (Check Applicable Box): Residential  Municipal  Industrial  Agricultural  Monitoring   
 Recovery  Heat Pump Water Injection  Other  If Other, List Use: \_\_\_\_\_

2. WELL LOCATION: (Show sketch of the location below)  
 Nearest Town: SPRUCE PINE County: AVERY  
BRUSHY CREEK RD. OFF HWY 19E  
(Road Name and Numbers, Community, or Subdivision and Lot No.)

3. DATE DRILLED 2/28/2003  
 4. TOTAL DEPTH 380  
 6. CUTTINGS COLLECTED YES  NO   
 7. DOES WELL REPLACE EXISTING WELL? YES  NO   
 8. STATIC WATER LEVEL Below Top of Casing: 10 FT.  
(Use "+" if Above Top of Casing)

DRILLING LOG		DEPTH
From	To	Formation Description
0	18	DIRT
18	25	GRANITE
25	27	SHALE
27	40	SANDSTONE
40	380	GRANITE

9. TOP OF CASING IS 1 FT. Above Land Surface\*  
\*Top of casing terminated at/or below land surface requires a variance in accordance with 15A NCAC 2C.0118  
 10. YIELD (gpm): 1.5 METHOD OF TEST Air  
 11. WATER ZONES (depth): 1.5 gpm 25-27 0 gpm  
 0 gpm 0 gpm  
 12. CHLORINATION: Type HTH Amount 71

13. CASING:  

From	To	Depth	Diameter	Wall Thickness or Weight/Ft.	Material
0	20	Ft.	6 1/4	188	GALV
From	To	Ft.			
From	To	Ft.			

14. GROUT:  

From	To	Depth	Material	Method
0	20	Ft.	Cement	Gravity Flow
From	To	Ft.		



15. SCREEN:  

From	To	Depth	Diameter	Slot Size	Material
From	To	Ft.	in.	in.	
From	To	Ft.	in.	in.	
From	To	Ft.	in.	in.	

16. SAND/GRAVEL PACK:  

From	To	Depth	Size	Material
From	To	Ft.		
From	To	Ft.		

17. REMARKS: I DO HEREBY CERTIFY THAT THIS WELL WAS CONSTRUCTED IN ACCORDANCE WITH 15A NCAC 2C, WELL CONSTRUCTION STANDARDS, AND THAT A COPY OF THIS RECORD HAS BEEN PROVIDED TO THE WELL OWNER.

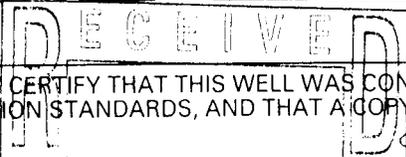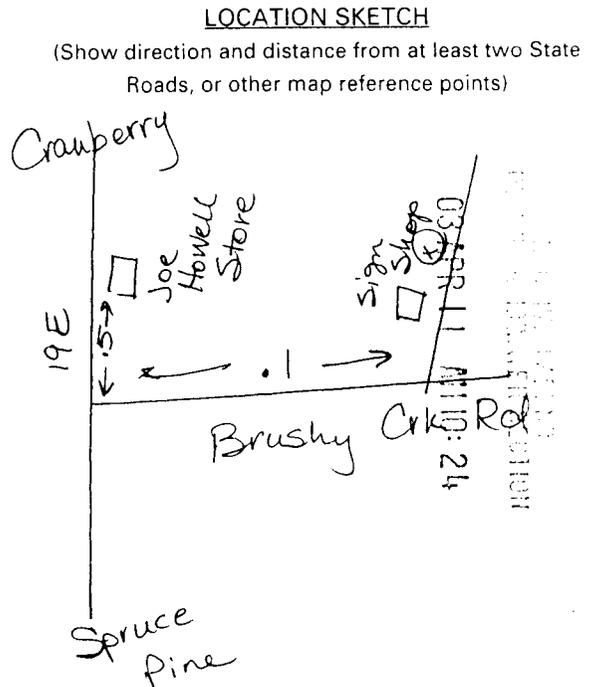

Signature: Steve Reece  
 SIGNATURE OF PERSON CONSTRUCTING THE WELL DATE

FOR OFFICE USE ONLY  
 Quad No: \_\_\_\_\_  
 Serial No: \_\_\_\_\_