

274845

WELL CONSTRUCTION RECORD

030126

WELL CONTRACTOR: Dewey Wright Well Pump Co., Inc.
 WELL CONTRACTOR CERTIFICATION #: 2878
 STATE WELL CONSTRUCTION PERMIT#: Steve Price

1. WELL USE (Check Applicable Box): Residential Municipal Industrial Agricultural Monitoring
 Recovery Heat Pump Water Injection Other If Other, List Use: _____

2. WELL LOCATION: (Show sketch of the location below)
 Nearest Town: LINVILLE County: AVERY
OLD JONAS RIDGE RD. OFF HWY 221
(Road Name and Numbers, Community, or Subdivision and Lot No.)

DRILLING LOG

DEPTH

From	To	Formation Description
0	170	DIRT
170	265	GRANITE
265	266	GRANITE
266	285	GRANITE

3. DATE DRILLED 4/14/2003
 4. TOTAL DEPTH 285
 5. CUTTINGS COLLECTED YES NO
 6. DOES WELL REPLACE EXISTING WELL? YES NO
 7. STATIC WATER LEVEL Below Top of Casing: 00 FT.
(Use "+" if Above Top of Casing)

9. TOP OF CASING IS 1 FT. Above Land Surface*
*Top of casing terminated at/or below land surface requires a variance in accordance with 15A NCAC 2C.0118.

10. YIELD (gpm): 10 gpm 265-266 Air 0 gpm
 11. WATER ZONES (depth): 0 gpm 0 gpm
 12. CHLORINATION: Type PTH Amount 46

13. CASING:

From	To	Depth	Diameter	Wall Thickness or Weight/Ft.	Material
0	175	Ft.	6 1/8	350	PVC
From	To	Ft.			
From	To	Ft.			

14. GROUT:

From	To	Depth	Material	Method
0	20	Ft.	Cement	Gravity Flow
From	To	Ft.		


15. SCREEN:

From	To	Depth	Diameter	Slot Size	Material
From	To	Ft.	in.	in.	
From	To	Ft.	in.	in.	
From	To	Ft.	in.	in.	

16. SAND/GRAVEL PACK:

From	To	Depth	Size	Material
From	To	Ft.		
From	To	Ft.		

17. REMARKS:
 I DO HEREBY CERTIFY THAT THIS WELL WAS CONSTRUCTED IN ACCORDANCE WITH 15A NCAC 2C, WELL CONSTRUCTION STANDARDS, AND THAT A COPY OF THIS RECORD HAS BEEN PROVIDED TO THE WELL OWNER.

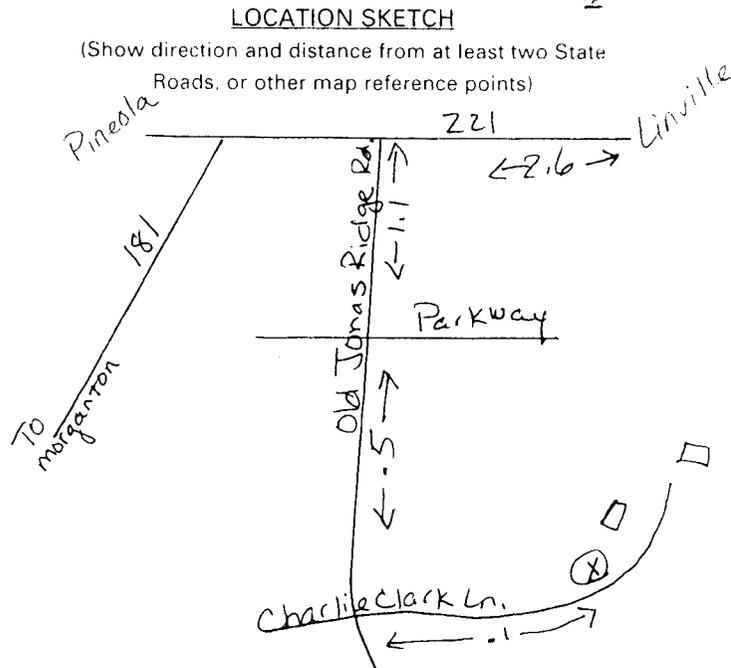

RECEIVED / DEPT. ENVIRONMENTAL PROTECTION
 03 JUN 18 PM 2:37

If additional space is needed use back of form

FOR OFFICE USE ONLY
 Quad No: _____
 Serial No: _____

Steve Price
 SIGNATURE OF PERSON CONSTRUCTING THE WELL
 Submit original to Division of Water Quality, Groundwater Section within 30 days

6-11-03
 DATE