

274862

WELL CONSTRUCTION RECORD

WELL CONTRACTOR: Dewey Wright Well Pump Co., Inc.
 WELL CONTRACTOR CERTIFICATION #: 2688
 STATE WELL CONSTRUCTION PERMIT#: Leslie Reece

030150

1. WELL USE (Check Applicable Box): Residential Municipal Industrial Agricultural Monitoring
 Recovery Heat Pump Water Injection Other If Other, List Use: _____

2. WELL LOCATION: (Show sketch of the location below)
 Nearest Town: BANNER ELK County: AVERY
DOBBINS RD. OFF HWY 184 OFF HWY 105
(Road Name and Numbers, Community, or Subdivision and Lot No.)

DRILLING LOG		DEPTH
From	To	Formation Description
0	99	DIRT MUD
99	183	GRANITE
183	184	SHALE
4184	277	GRANITE
277	278	QUARTZ
278	300	GRANITE

03 JUN 13 PM 2:37
 DIVISION OF WATER QUALITY
 GROUNDWATER SECTION

4. DATE DRILLED 4/28/2003
 5. TOTAL DEPTH 300
 6. CUTTINGS COLLECTED YES NO
 7. DOES WELL REPLACE EXISTING WELL? YES NO
 8. STATIC WATER LEVEL Below Top of Casing: 10 FT.
(Use "+" if Above Top of Casing)

9. TOP OF CASING IS 1 FT. Above Land Surface*
*Top of casing terminated at/or below land surface requires a variance in accordance with 15A NCAC 2C.0118

10. YIELD (gpm): 5 METHOD OF TEST Air
 11. WATER ZONES (depth): HTH 0 gpm 0 gpm
0 gpm 0 gpm
58

12. CHLORINATION: Type _____ Amount 58


13. CASING:
 From 0 To 103 Ft. Diameter 6 1/8 Wall Thickness or Weight/Ft. .350 Material PVC
 From _____ To _____ Ft. _____
 From _____ To _____ Ft. _____

14. GROUT:
 From 0 To 20 Ft. Material Cement Method Gravity Flow
 From _____ To _____ Ft. _____

15. SCREEN:
 From _____ To _____ Ft. Diameter _____ Slot Size _____ Material _____
 From _____ To _____ Ft. _____
 From _____ To _____ Ft. _____

16. SAND/GRAVEL PACK:
 From _____ To _____ Ft. Size _____ Material _____
 From _____ To _____ Ft. _____

17. REMARKS:
 I DO HEREBY CERTIFY THAT THIS WELL WAS CONSTRUCTED IN ACCORDANCE WITH 15A NCAC 2C, WELL CONSTRUCTION STANDARDS, AND THAT A COPY OF THIS RECORD HAS BEEN PROVIDED TO THE WELL OWNER.

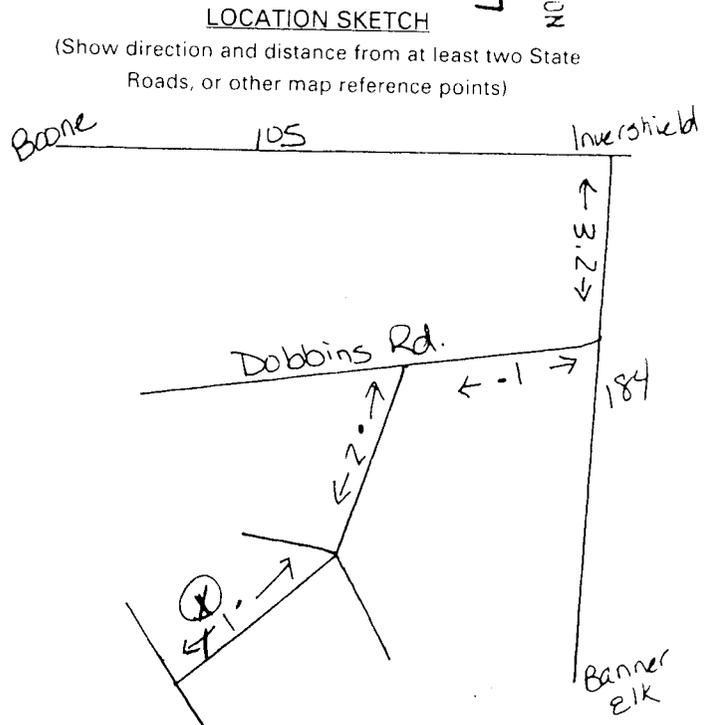

FOR OFFICE USE ONLY

Quad No: _____

Serial No. _____

GROUNDWATER SECTION
 ASHVILLE REGIONAL OFFICE

Leslie Wayne Reece SIGNATURE OF PERSON CONSTRUCTING THE WELL
 DATE 6-11-03
 Submit original to Division of Water Quality, Groundwater Section within 30 days