

275588

WELL CONSTRUCTION RECORD

North Carolina - Department of Environment and Natural Resources - Division of Water Quality - Groundwater Section

WELL CONTRACTOR (INDIVIDUAL) NAME (print) Kenneth Jordan CERTIFICATION # 2669

WELL CONTRACTOR COMPANY NAME Draswell PHONE # () _____

STATE WELL CONSTRUCTION PERMIT# _____ ASSOCIATED WQ PERMIT# _____
(if applicable) (if applicable)

1. WELL USE (Check Applicable Box): Residential Municipal/Public Industrial Agricultural
Monitoring Recovery Heat Pump Water Injection Other If Other, List Use private

2. WELL LOCATION:

Nearest Town: Crossage County Hwy 9
12 Altamont Acres Rd.
(Street Name, Numbers, Community, Subdivision, Lot No., Zip Code) home owned

Topographic/Land setting
 Ridge Slope Valley Flat
(check appropriate box)
Latitude/longitude of well location _____

3. _____
(degrees/minutes/seconds)
Latitude/longitude source: GPS Topographic map
(check box)

Area code- Phone number _____

4. DATE DRILLED 3-10-03

5. TOTAL DEPTH: 220

6. DOES WELL REPLACE EXISTING WELL? YES NO

7. STATIC WATER LEVEL Below Top of Casing: 10 FT.
(Use "+" if Above Top of Casing)

8. TOP OF CASING IS 4 FT. Above Land Surface*

*Top of casing terminated at/or below land surface requires a variance in accordance with 15A NCAC 2C .0118.

9. YIELD (gpm): 5 METHOD OF TEST Air

10. WATER ZONES (depth): 127-130 gravel
161-163 sand

11. DISINFECTION: Type HTH Amount 3.04

12. CASING: _____ Wall Thickness _____

From 4 To 110 Ft. Diameter 6.5 or Weight/Ft. 188 Material Galv

From _____ To _____ Ft. _____

From _____ To _____ Ft. _____

13. GROUT: _____

From 0 To 20 Ft. Material cc grout Method poural

From _____ To _____ Ft. _____

14. SCREEN: _____

From _____ To _____ Ft. _____ in. _____ in. Material _____

From _____ To _____ Ft. _____ in. _____ in. _____

15. SAND/GRAVEL PACK: _____

From _____ To _____ Depth _____ Size _____ Material _____


From _____ To _____ Depth _____ Size _____ Material _____

16. REMARKS: _____

DEPTH		DRILLING LOG
From	To	Formation Description
<u>0-110</u>		<u>brwn ls, granite</u>
<u>110-127</u>		<u>granite</u>
<u>127-130</u>		<u>brwn shale</u>
<u>130-161</u>		<u>granite</u>
<u>161-163</u>		<u>brwn shale</u>
<u>163-220</u>		<u>granite</u>

LOCATION SKETCH

Show direction and distance in miles from at least two State Roads or County Roads. Include the road numbers and common road names.

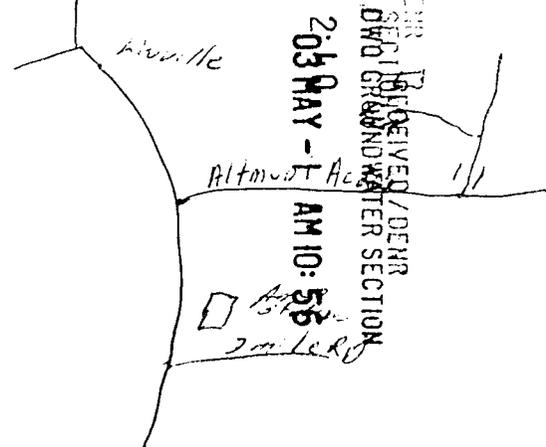

RECEIVED / DENR
GROUNDWATER SECTION
03 JUL 19 2:05 PM
AM 10:55
2 miles

I DO HEREBY CERTIFY THAT THIS WELL WAS CONSTRUCTED IN ACCORDANCE WITH 15A NCAC 2C, WELL CONSTRUCTION STANDARDS, AND THAT A COPY OF THIS RECORD HAS BEEN PROVIDED TO THE WELL OWNER

Kenneth Jordan 3-10-03
SIGNATURE OF PERSON CONSTRUCTING THE WELL DATE