

278118

WELL CONSTRUCTION RECORD

WELL CONTRACTOR: Dewey Wright Well Pump Co., Inc.
 WELL CONTRACTOR CERTIFICATION #: 2686
 STATE WELL CONSTRUCTION PERMIT#: Leslie Reece

030301

1. WELL USE (Check Applicable Box): Residential Municipal Industrial Agricultural Monitoring
 Recovery Heat Pump Water Injection Other If Other, List Use: _____


2. WELL LOCATION: (Show sketch of the location below)
 Nearest Town: BANNER ELK County: AVERY
FLAT SPRINGS RD 4/10 MILE OFF BUCKEYE RD #1309 0
(Road Name and Numbers, Community, or Subdivision and Lot No.)

3. DRILLING LOG

From	To	DEPTH Formation Description
0	80	DIRT
80	97	GRANITE
97	98	SHALE
98	141	GRANITE
141	142	SHALE
142	185	GRANITE

4. DATE DRILLED 6/30/2003
 5. TOTAL DEPTH 185
 6. CUTTINGS COLLECTED YES NO
 7. DOES WELL REPLACE EXISTING WELL? YES NO
 8. STATIC WATER LEVEL Below Top of Casing: 50 FT.
(Use "+" if Above Top of Casing)

9. TOP OF CASING IS 1 FT. Above Land Surface*
*Top of casing terminated at/or below land surface requires a variance in accordance with 15A NCAC 2C.0118
 10. YIELD (gpm): 7 METHOD OF TEST Air
 11. WATER ZONES (depth): 3 gpm 97-98 4 gpm 141-142
0 gpm 0 gpm
 12. CHLORINATION: Type HTH Amount 27

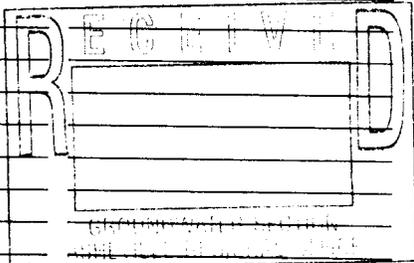

13. CASING:

From	To	Depth	Diameter	Wall Thickness or Weight/Ft.	Material
0	83 Ft.		6 1/8	350	PVC
83					

14. GROUT:

From	To	Depth	Material	Method
0	20 Ft.		Cement	Gravity Flow
20			CEMENT	GRAVITY FLOW


15. SCREEN:

From	To	Depth	Diameter	Slot Size	Material

16. SAND/GRAVEL PACK:

From	To	Depth	Size	Material

17. REMARKS: _____
 I DO HEREBY CERTIFY THAT THIS WELL WAS CONSTRUCTED IN ACCORDANCE WITH 15A NCAC 2C, WELL CONSTRUCTION STANDARDS, AND THAT A COPY OF THIS RECORD HAS BEEN PROVIDED TO THE WELL OWNER.

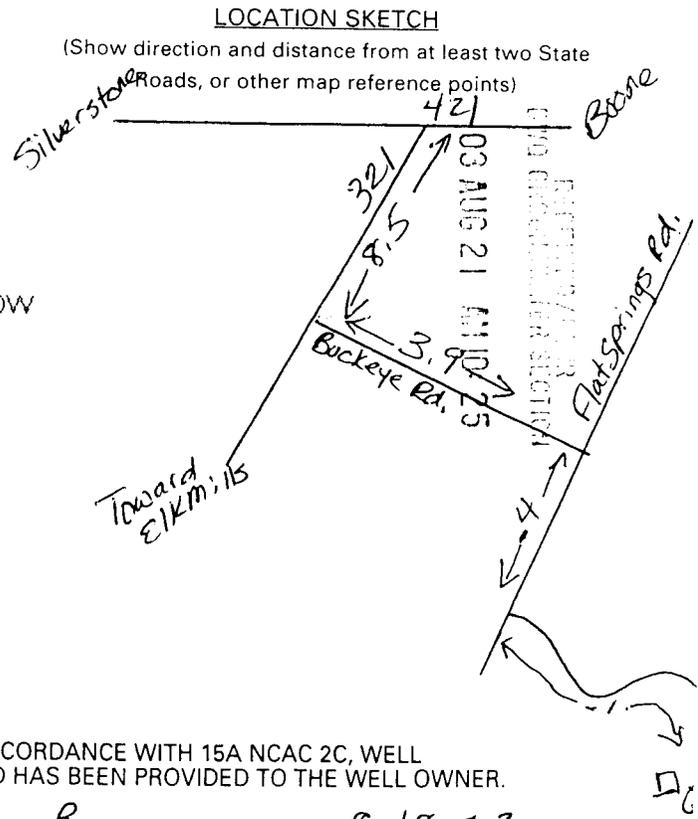

FOR OFFICE USE ONLY
 Quad No: _____
 Serial No. _____

Leslie Wayne Reece 8-18-03
 SIGNATURE OF PERSON CONSTRUCTING THE WELL DATE
 Submit original to Division of Water Quality, Groundwater Section within 30 days