

278161

**WELL CONSTRUCTION RECORD**

030255

WELL CONTRACTOR: Dewey Wright Well Pump Co., Inc.

WELL CONTRACTOR CERTIFICATION #: 2886

STATE WELL CONSTRUCTION PERMIT#: Leslie Reece

1. WELL USE (Check Applicable Box): Residential  Municipal  Industrial  Agricultural  Monitoring   
 Recovery  Heat Pump Water Injection  Other  If Other, List Use: \_\_\_\_\_

2. WELL LOCATION: (Show sketch of the location below)

Nearest Town: BANNER ELK County: AVERY

THE FARM OFF DOBBINS RD OFF HWY 184 OFF HWY 1  
(Road Name and Numbers, Community, or Subdivision and Lot No.)

3. DATE DRILLED 7/17/2003  
 4. TOTAL DEPTH 205  
 5. CUTTINGS COLLECTED YES  NO   
 6. DOES WELL REPLACE EXISTING WELL? YES  NO   
 7. STATIC WATER LEVEL Below Top of Casing: 50 FT.  
(Use "+" if Above Top of Casing)

9. TOP OF CASING IS 1 FT. Above Land Surface\*  
\*Top of casing terminated at/or below land surface requires a variance in accordance with 15A NCAC 2C.0118

10. YIELD (gpm): 20 METHOD OF TEST Air  
 11. WATER ZONES (depth): 20 gpm 171-172 0 gpm  
0 gpm 0 gpm

12. CHLORINATION: Type HTH Amount 31

13. CASING:  

From	To	Depth	Diameter	Wall Thickness or Weight/Ft.	Material
0	107	Ft.	6 1/8	350	PVC
_____	_____	Ft.	_____	_____	_____
_____	_____	Ft.	_____	_____	_____

14. GROUT:  

From	To	Depth	Material	Method
0	20	Ft.	Cement	Gravity Flow
_____	_____	Ft.	_____	_____


15. SCREEN:  

From	To	Depth	Diameter	Slot Size	Material
_____	_____	Ft.	_____ in.	_____ in.	_____
_____	_____	Ft.	_____ in.	_____ in.	_____
_____	_____	Ft.	_____ in.	_____ in.	_____

16. SAND/GRAVEL PACK:  

From	To	Depth	Size	Material
_____	_____	Ft.	_____	_____
_____	_____	Ft.	_____	_____


DRILLING LOG		DEPTH
From	To	Formation Description
0	100	DIRT
100	171	GRANITE
171	172	SHALE
172	205	GRANITE

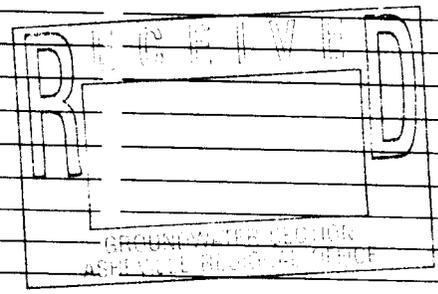

If additional space is needed use back of form

**LOCATION SKETCH**

(Show direction and distance from at least two State Roads, or other map reference points)

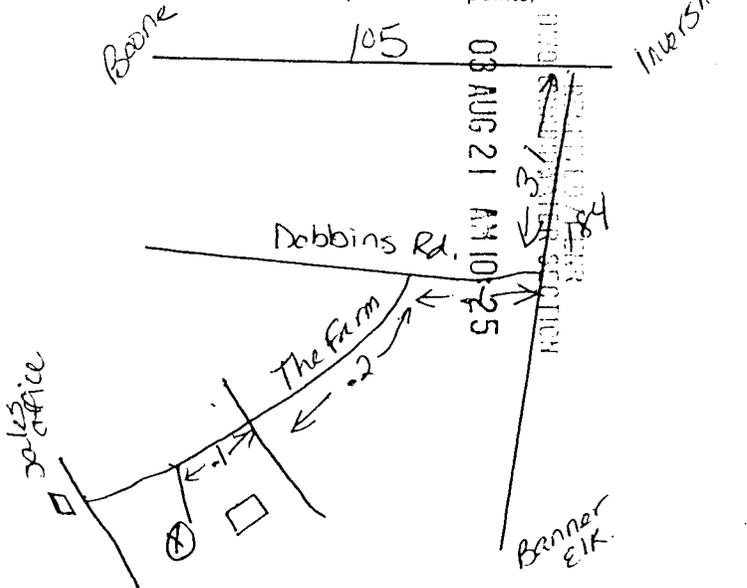

17. REMARKS: \_\_\_\_\_  
 I DO HEREBY CERTIFY THAT THIS WELL WAS CONSTRUCTED IN ACCORDANCE WITH 15A NCAC 2C, WELL CONSTRUCTION STANDARDS, AND THAT A COPY OF THIS RECORD HAS BEEN PROVIDED TO THE WELL OWNER.

**FOR OFFICE USE ONLY**  
 Quad No: \_\_\_\_\_  
 Serial No. \_\_\_\_\_

Leslie Wayne Reece 8-18-03  
 SIGNATURE OF PERSON CONSTRUCTING THE WELL DATE  
 Submit original to Division of Water Quality, Groundwater Section within 30 days