

278901

WELL CONSTRUCTION RECORD

WELL CONTRACTOR: Dewey Wright Well Pump Co., Inc.
 WELL CONTRACTOR CERTIFICATION #: 2887
 STATE WELL CONSTRUCTION PERMIT#: Steve Reece


030401

1. WELL USE (Check Applicable Box): Residential Municipal Industrial Agricultural Monitoring
 Recovery Heat Pump Water Injection Other If Other, List Use: _____

2. WELL LOCATION: (Show sketch of the location below)

Nearest Town: BANNER ELK County: AVERY

JENNINGS LANE OFF HORNEY HOLLOW OFF EDGAR T
(Road Name and Numbers, Community, or Subdivision and Lot No.)

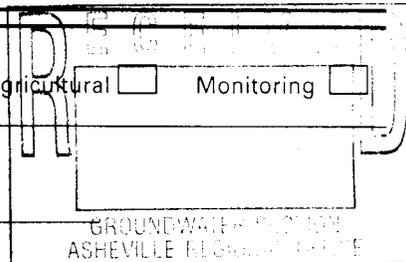

3. ()
 4. DATE DRILLED 8/15/2003
 5. TOTAL DEPTH 220
 6. CUTTINGS COLLECTED YES NO
 7. DOES WELL REPLACE EXISTING WELL? YES NO
 8. STATIC WATER LEVEL Below Top of Casing: 50 FT.
(Use "+" if Above Top of Casing)

DRILLING LOG

DEPTH

| From | To | Formation Description |
|------|-----|-----------------------|
| 0 | 55 | DIRT |
| 55 | 65 | GRANITE |
| 65 | 67 | SHALE |
| 67 | 220 | GRANITE |

9. TOP OF CASING IS 1 FT. Above Land Surface*
*Top of casing terminated at/or below land surface requires a variance in accordance with 15A NCAC 2C.0118

10. YIELD (gpm): 10 METHOD OF TEST Air

11. WATER ZONES (depth): 10 gpm 65-67 0 gpm
0 gpm 0 gpm

12. CHLORINATION: Type HTH Amount 36

13. CASING:

| From | Depth | To | Diameter | Wall Thickness or Weight/Ft. | Material |
|------|-------|--------|----------|------------------------------|----------|
| 0 | | 62 Ft. | 6 1/8 | 350 | PVC |
| From | | To | Ft. | | |
| From | | To | Ft. | | |

14. GROUT:

| From | Depth | To | Material | Method |
|------|-------|--------|----------|--------------|
| 0 | | 20 Ft. | Cement | Gravity Flow |
| From | | To | Ft. | |

15. SCREEN:


| From | Depth | To | Diameter | Slot Size | Material |
|------|-------|----|----------|-----------|----------|
| From | | To | Ft. | in. | in. |
| From | | To | Ft. | in. | in. |
| From | | To | Ft. | in. | in. |

16. SAND/GRAVEL PACK:

| From | Depth | To | Size | Material |
|------|-------|----|------|----------|
| From | | To | Ft. | |
| From | | To | Ft. | |

17. REMARKS:

I DO HEREBY CERTIFY THAT THIS WELL WAS CONSTRUCTED IN ACCORDANCE WITH 15A NCAC 2C.0118, WELL CONSTRUCTION STANDARDS, AND THAT A COPY OF THIS RECORD HAS BEEN PROVIDED TO THE WELL OWNER.

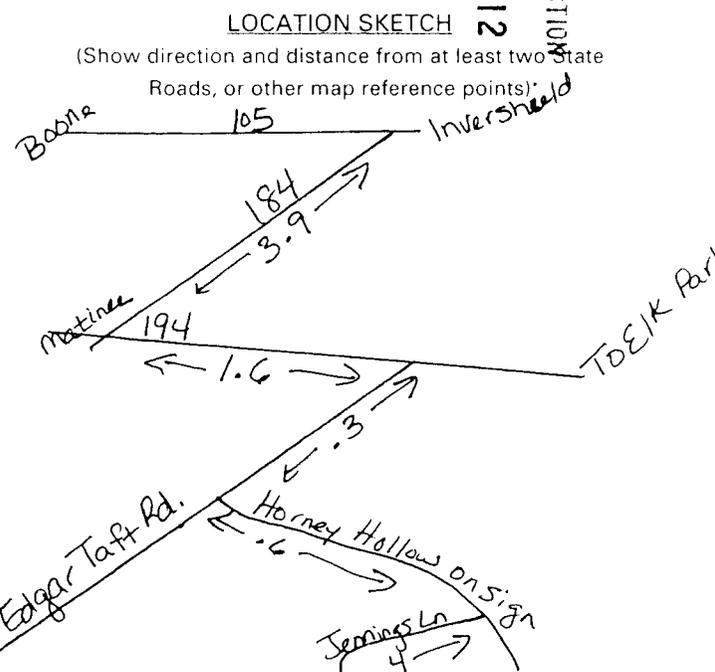

RECEIVED/DIR DIVISION OF WATER RESOURCES 03 SEP 11 PM 2:12

If additional space is needed use back of form

LOCATION SKETCH

(Show direction and distance from at least two State Roads, or other map reference points):

FOR OFFICE USE ONLY

Quad No: _____

Serial No: _____

SIGNATURE OF PERSON CONSTRUCTING THE WELL
 Submit original to Division of Water Quality, Groundwater Section within 30 days

DATE

Steve Reece 9-5-03