


282053

WELL CONSTRUCTION RECORD

WELL CONTRACTOR: Dewey Wright Well Pump Co., Inc.
 WELL CONTRACTOR CERTIFICATION #: 2687
 STATE WELL CONSTRUCTION PERMIT#: Steve Reece

030517

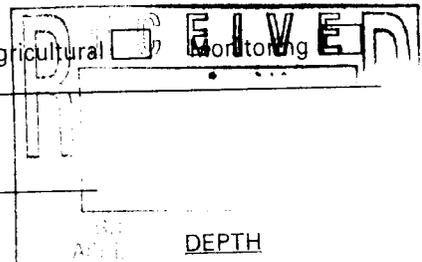

1. WELL USE (Check Applicable Box): Residential Municipal Industrial Agricultural Working
 Recovery Heat Pump Water Injection Other If Other, List Use: _____

2. WELL LOCATION: (Show sketch of the location below)
 Nearest Town: BANNER ELK County: AVERY
CREEK MEADOWS RD OFF BEECH MTL RD OFF HWY
(Road Name and Numbers, Community, or Subdivision and Lot No.)

DRILLING LOG

From	To	FORMATION DESCRIPTION
0	35	DIRT
35	100	GRANITE
100	104	QUARTZ
104	120	GRANITE
120	123	QUARTZ
123	200	GRANITE

3. _____
 4. DATE DRILLED 10/8/2003
 5. TOTAL DEPTH 200
 6. CUTTINGS COLLECTED YES NO
 7. DOES WELL REPLACE EXISTING WELL? YES NO
 8. STATIC WATER LEVEL Below Top of Casing: 40 FT.
(Use "+" if Above Top of Casing)

9. TOP OF CASING IS 1 FT. Above Land Surface*
*Top of casing terminated at/or below land surface requires a variance in accordance with 15A NCAC 2C.0118
 10. YIELD (gpm): 5 METHOD OF TEST Air
 11. WATER ZONES (depth): 3.00 gpm 100-104 2.00 gpm 120-123
0.00 gpm 0.00 gpm

12. CHLORINATION: Type HTH Amount 32

13. CASING:

Depth	Diameter	Wall Thickness or Weight/Ft.	Material
From <u>0</u> To <u>44</u> Ft.	<u>6 1/8</u>	<u>350</u>	<u>PVC</u>
From _____ To _____ Ft.	_____	_____	_____
From _____ To _____ Ft.	_____	_____	_____

14. GROUT:

Depth	Material	Method
From <u>0</u> To <u>20</u> Ft.	<u>Cement</u>	<u>Gravity Flow</u>
From _____ To _____ Ft.	<u>CEMENT</u>	<u>GRAVITY FLOW</u>


15. SCREEN:

Depth	Diameter	Slot Size	Material
From _____ To _____ Ft.	_____ in.	_____ in.	_____
From _____ To _____ Ft.	_____ in.	_____ in.	_____
From _____ To _____ Ft.	_____ in.	_____ in.	_____

16. SAND/GRAVEL PACK:

Depth	Size	Material
From _____ To _____ Ft.	_____	_____
From _____ To _____ Ft.	_____	_____

17. REMARKS: _____
 I DO HEREBY CERTIFY THAT THIS WELL WAS CONSTRUCTED IN ACCORDANCE WITH 15A NCAC 2C, WELL CONSTRUCTION STANDARDS, AND THAT A COPY OF THIS RECORD HAS BEEN PROVIDED TO THE WELL OWNER.

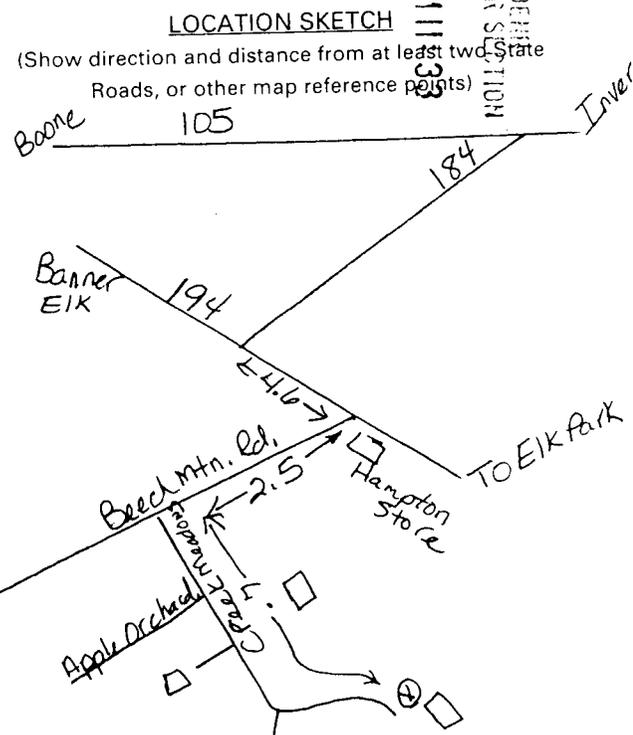

FOR OFFICE USE ONLY
 Quad No: _____

Steve Reece 10-21-03
 SIGNATURE OF PERSON CONSTRUCTING THE WELL DATE
 Submit original to Division of Water Quality, Groundwater Section within 30 days GW-1 REV. 12/99