


282053

**WELL CONSTRUCTION RECORD**

WELL CONTRACTOR: Dewey Wright Well Pump Co., Inc.  
 WELL CONTRACTOR CERTIFICATION #: 2687  
 STATE WELL CONSTRUCTION PERMIT#: Steve Reese

030450

1. WELL USE (Check Applicable Box): Residential  Municipal  Industrial   
 Recovery  Heat Pump Water Injection  Other  If Other, List Use: \_\_\_\_\_

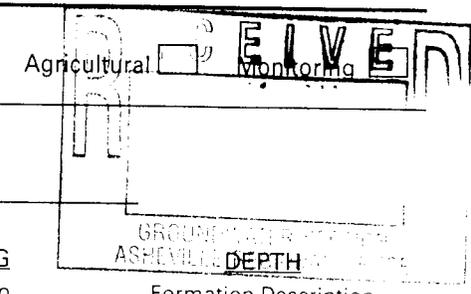

2. WELL LOCATION: (Show sketch of the location below)  
 Nearest Town: BANNER ELK County: AVERY  
OFF HICKORY NUT GAP OFF HWY 184 OFF HWY 105  
(Road Name and Numbers, Community, or Subdivision and Lot No.)

**DRILLING LOG**

From	To	Formation Description
0	10	DIRT
10	90	GRANITE
90	93	SHALE
93	500	GRANITE

3. DATE DRILLED 10/8/2003  
 4. TOTAL DEPTH 500  
 6. CUTTINGS COLLECTED YES  NO   
 7. DOES WELL REPLACE EXISTING WELL? YES  NO   
 8. STATIC WATER LEVEL Below Top of Casing: 50 FT.  
(Use "+" if Above Top of Casing)

9. TOP OF CASING IS 1 FT. Above Land Surface\*  
\*Top of casing terminated at/or below land surface requires a variance in accordance with 15A NCAC 2C.0118

10. YIELD (gpm): 1 METHOD OF TEST Air  
 11. WATER ZONES (depth): 1.00 gpm 90-93 0.00 gpm  
0.00 gpm 0.00 gpm  
 12. CHLORINATION: Type HTH Amount 92


13. CASING:  
 From 0 To 21 Ft. Diameter 6 1/4 Wall Thickness or Weight/Ft. 185 Material GALV  
 From \_\_\_\_\_ To \_\_\_\_\_ Ft. \_\_\_\_\_  
 From \_\_\_\_\_ To \_\_\_\_\_ Ft. \_\_\_\_\_

14. GROUT:  
 From 0 To 20 Ft. Material Cement Method Gravity Flow  
 From \_\_\_\_\_ To \_\_\_\_\_ Ft. CEMENT GRAVITY FLOW

15. SCREEN:  
 Depth Diameter Slot Size Material  
 From \_\_\_\_\_ To \_\_\_\_\_ Ft. \_\_\_\_\_ in. \_\_\_\_\_ in. \_\_\_\_\_  
 From \_\_\_\_\_ To \_\_\_\_\_ Ft. \_\_\_\_\_ in. \_\_\_\_\_ in. \_\_\_\_\_  
 From \_\_\_\_\_ To \_\_\_\_\_ Ft. \_\_\_\_\_ in. \_\_\_\_\_ in. \_\_\_\_\_

16. SAND/GRAVEL PACK:  
 Depth Size Material  
 From \_\_\_\_\_ To \_\_\_\_\_ Ft. \_\_\_\_\_  
 From \_\_\_\_\_ To \_\_\_\_\_ Ft. \_\_\_\_\_

17. REMARKS: \_\_\_\_\_  
 I DO HEREBY CERTIFY THAT THIS WELL WAS CONSTRUCTED IN ACCORDANCE WITH 15A NCAC 2C, WELL CONSTRUCTION STANDARDS, AND THAT A COPY OF THIS RECORD HAS BEEN PROVIDED TO THE WELL OWNER.

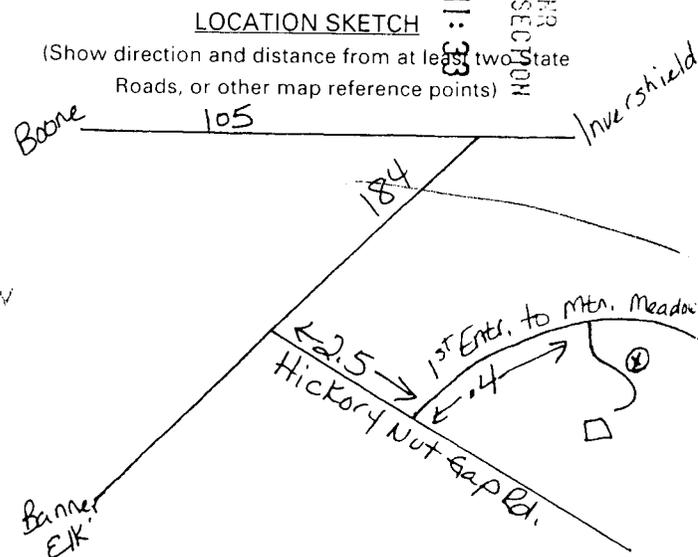

RECEIVED / ENR  
 DIVISION OF WATER QUALITY  
 GROUNDWATER SECTION  
 03 OCT 27 9 11:33 AM

If additional space is needed use back of form

**LOCATION SKETCH**

(Show direction and distance from at least two State Roads, or other map reference points)

**FOR OFFICE USE ONLY**  
 Quad No: \_\_\_\_\_  
 Serial No. \_\_\_\_\_

Steve Reese 10-21-03  
 SIGNATURE OF PERSON CONSTRUCTING THE WELL DATE