

284057

WELL CONSTRUCTION RECORD

WELL CONTRACTOR: Dewey Wright Well Pump Co., Inc.
 WELL CONTRACTOR CERTIFICATION #: 2887
 STATE WELL CONSTRUCTION PERMIT#: Steve Reece

030586

1. WELL USE (Check Applicable Box): Residential Municipal Industrial Agricultural Monitoring
 Recovery Heat Pump Water Injection Other If Other, List Use: _____

2. WELL LOCATION: (Show sketch of the location below)
 Nearest Town: FOSCOE County: AVERY
ELK HILL DR. OFF HWY 184 OFF HWY 105
(Road Name and Numbers, Community, or Subdivision and Lot No.)

DRILLING LOG		DEPTH
From	To	Formation Description
0	50	DIRT
50	133	GRANITE
133	137	SHALE QUARTZ
137	218	GRANITE
218	221	QUARTZ
221	300	GRANITE

3. DATE DRILLED 11/18/2003
 4. TOTAL DEPTH 300
 5. CUTTINGS COLLECTED YES NO
 6. DOES WELL INTERFERE WITH EXISTING WELL? YES NO
 7. STATIC WATER LEVEL Below Top of Casing: 120 FT.
(Use "+" if Above Top of Casing)

8. TOP OF CASING IS 1 FT. Above Land Surface*
*Top of casing set at or below land surface requires a variance in accordance with 15A NCAC 2C.0118

9. YIELD (gpm): 25 METHOD OF TEST Air
 10. WATER ZONES (depth): 20.00 gpm 133-137 5.00 gpm 218-221
0.00 gpm 0.00 gpm
 11. CHLORINATION: Type HTH Amount 37

13. CASING:

From	To	Depth	Diameter	Wall Thickness or Weight/Ft.	Material
0	84	Ft.	6 1/4	.188	GALV
84	_____	Ft.	_____	_____	_____
_____	_____	Ft.	_____	_____	_____

14. GROUT:

From	To	Depth	Material	Method
0	20	Ft.	Cement	Gravity Flow
20	_____	Ft.	_____	_____


15. SCREEN:

From	To	Depth	Diameter	Slot Size	Material
_____	_____	Ft.	_____ in.	_____ in.	_____
_____	_____	Ft.	_____ in.	_____ in.	_____
_____	_____	Ft.	_____ in.	_____ in.	_____

16. SAND/GRAVEL PACK:

From	To	Depth	Size	Material
_____	_____	Ft.	_____	_____
_____	_____	Ft.	_____	_____

17. REMARKS: _____
 I DO HEREBY CERTIFY THAT THIS WELL WAS CONSTRUCTED IN ACCORDANCE WITH 15A NCAC 2C, WELL CONSTRUCTION STANDARDS, AND THAT A COPY OF THIS RECORD HAS BEEN PROVIDED TO THE WELL OWNER.

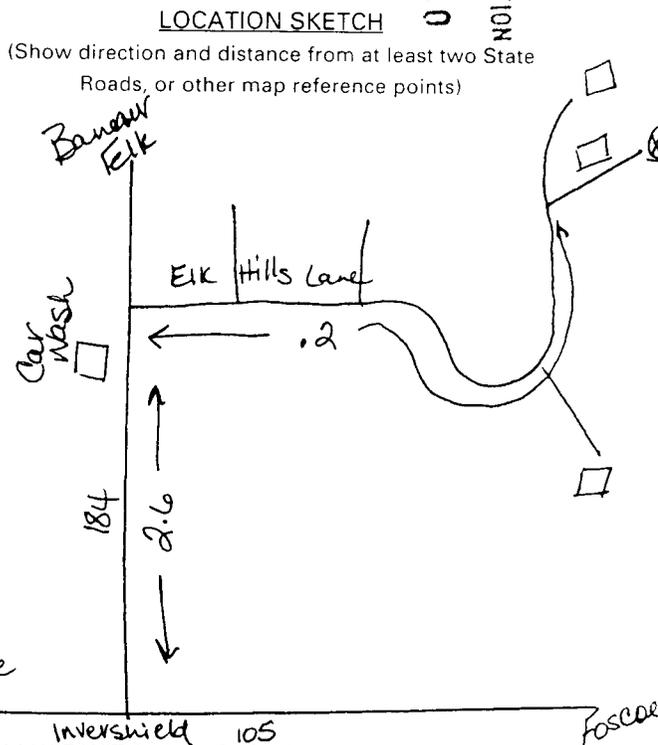

RECEIVED / DENIED SECTION
 DWD GROUNDWATER SECTION
 04 JAN - 7 AM 11:10

FOR OFFICE USE ONLY

Quad No: _____

Serial No. _____

Steve Reece 12-15-03
 SIGNATURE OF PERSON CONSTRUCTING THE WELL DATE
 Submit original to Division of Water Quality, Groundwater Section within 30 days
 GW-1 REV. 12/99