

292355

WELL CONSTRUCTION RECORD

WELL CONTRACTOR: Dewey Wright Well Pump Co., Inc.
 WELL CONTRACTOR CERTIFICATION #: 2886
 STATE WELL CONSTRUCTION PERMIT#: Leslie Reece

030006

1. WELL USE (Check Applicable Box): Residential Municipal Industrial Agricultural Monitoring
 Recovery Heat Pump Water Injection Other If Other, List Use: _____

2. WELL LOCATION: (Show sketch of the location below)
 Nearest Town: SPRUCE PINE County: AVERY
GREEN OAK'S LN. OFF JERRYS CRK OFF ROARING CR
(Road Name and Numbers, Community, or Subdivision and Lot No.)

3. DATE DRILLED 11/14/2003
 4. TOTAL DEPTH 200
 6. CUTTINGS COLLECTED YES NO
 7. DOES WELL REPLACE EXISTING WELL? YES NO
 8. STATIC WATER LEVEL Below Top of Casing: 60 FT.
(Use "+" if Above Top of Casing)

DRILLING LOG		DEPTH
From	To	Formation Description
0	80	MUD GRAVEL BOULDER
80	96	GRANITE
96	97	SHALE
97	181	GRANITE
181	182	SHALE
182	200	GRANITE

9. TOP OF CASING IS 1 FT. Above Land Surface*
*Top of casing terminated at/or below land surface requires a variance in accordance with 15A NCAC 2C.0118
 10. YIELD (gpm): 10 METHOD OF TEST Air
 11. WATER ZONES (depth): 3.00 gpm 96-97 7.00 gpm 181-182
0.00 gpm 0.00 gpm

12. CHLORINATION: Type HTH Amount 28

13. CASING:

From	To	Depth	Diameter	Wall Thickness or Weight/Ft.	Material
0	84	Ft.	6 1/4	.188	GALV
From	To	Ft.			
From	To	Ft.			

14. GROUT:

From	To	Depth	Material	Method
0	20	Ft.	Cement	Gravity Flow
From	To	Ft.		

15. SCREEN:


From	To	Depth	Diameter	Slot Size	Material
From	To	Ft.	in.	in.	
From	To	Ft.	in.	in.	
From	To	Ft.	in.	in.	

16. SAND/GRAVEL PACK:

From	To	Depth	Size	Material
From	To	Ft.		
From	To	Ft.		

17. REMARKS: _____

LOCATION SKETCH
 (Show direction and distance from at least two State Roads, or other map reference points)

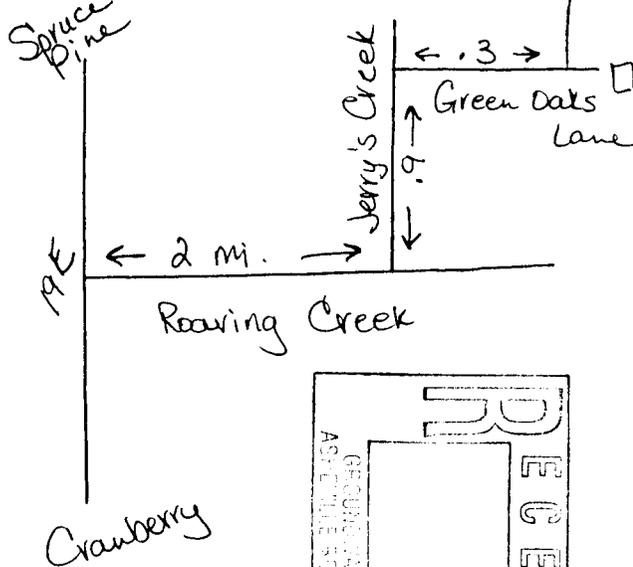

RECEIVED
 DIVISION OF WATER QUALITY
 DATE: 1-9-04

FOR OFFICE USE ONLY
 Quad No: _____
 Serial No: _____

Leslie Wayne Reece
 SIGNATURE OF PERSON CONSTRUCTING THE WELL
 Submit original to Division of Water Quality, Groundwater Section within 30 days