

WELL CONSTRUCTION RECORD

30305

North Carolina - Department of Environment and Natural Resources - Division of Water Quality - Groundwater Section

WELL CONTRACTOR (INDIVIDUAL) NAME (print) Kenneth Jordan CERTIFICATION # 2664

WELL CONTRACTOR COMPANY NAME Braswell Well Pump PHONE # () _____

STATE WELL CONSTRUCTION PERMIT# _____ ASSOCIATED WQ PERMIT# _____
(if applicable) (if applicable)

1. WELL USE (Check Applicable Box): Residential Municipal/Public Industrial Agricultural
Monitoring Recovery Heat Pump Water Injection Other If Other, List Use private

2. WELL LOCATION:
Nearest Town: Beaver Elk County Avery
Tipton Hill
(Street Name, Numbers, Community, Subdivision, Lot No., Zip Code)

Topographic/Land setting
 Ridge Slope Valley Flat
(check appropriate box)
Latitude/longitude of well location

3. (degrees/minutes/seconds)
Latitude/longitude source: GPS Topographic map
(check box)

DEPTH		DRILLING LOG
From	To	Formation Description
0	3	black dirt
3	60	granite
60	65	Drum shale
65	220	granite
220	221	clay
221	720	granite

4. DATE DRILLED 11-12-03
5. TOTAL DEPTH: 720
6. DOES WELL REPLACE EXISTING WELL? YES NO
7. STATIC WATER LEVEL Below Top of Casing: 60 FT.
(Use "+" if Above Top of Casing)
8. TOP OF CASING IS 1 FT. Above Land Surface*
*Top of casing terminated at/or below land surface requires a variance in accordance with 15A NCAC 2C .0118.
9. YIELD (gpm): 1.5 METHOD OF TEST Air
10. WATER ZONES (depth): 10-65.5
220-221 15 gal

11. DISINFECTION: Type HTHH Amount 402

12. CASING: Wall Thickness

From	To	Depth	Diameter	or Weight/Ft.	Material
From	From	From	From	From	From
<u>-1</u>	<u>20</u>	<u>Ft.</u>	<u>6 3/8</u>	<u>182</u>	<u>Galv</u>

13. GROUT: Method

From	To	Depth	Material	Method
From	From	From	From	From
<u>0</u>	<u>20</u>	<u>Ft.</u>	<u>Cement</u>	<u>Poured</u>

14. SCREEN: Material


From	To	Depth	Diameter	Slot Size	Material
From	From	From	From	From	From

15. SAND/GRAVEL PACK: Material

From	To	Depth	Size	Material
From	From	From	From	From

16. REMARKS: _____

LOCATION SKETCH
Show direction and distance in miles from at least two State Roads or County Roads. Include the road numbers and common road names.

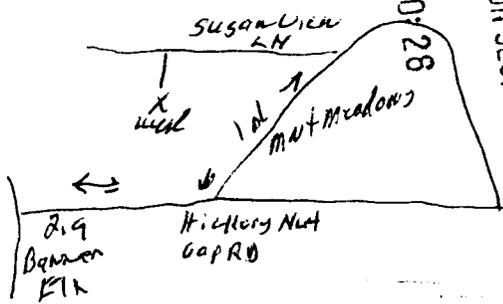

RECEIVED/DEMR/DWD
AQUIFER PROTECTION SEC.
04 DEC -8 AM 10:28

I DO HEREBY CERTIFY THAT THIS WELL WAS CONSTRUCTED IN ACCORDANCE WITH 15A NCAC 2C, WELL CONSTRUCTION STANDARDS, AND THAT A COPY OF THIS RECORD HAS BEEN PROVIDED TO THE WELL OWNER

Kenneth Jordan 11-12-03
SIGNATURE OF PERSON CONSTRUCTING THE WELL DATE