

WELL CONSTRUCTION RECORD

303056

North Carolina - Department of Environment and Natural Resources - Division of Water Quality - Groundwater Section

WELL CONTRACTOR (INDIVIDUAL) NAME (print) Kenneth Jordan CERTIFICATION # 2669
 WELL CONTRACTOR COMPANY NAME Braswell Well Drilling PHONE # () _____
 STATE WELL CONSTRUCTION PERMIT# _____ ASSOCIATED WQ PERMIT# _____
 (if applicable) (if applicable)

1. WELL USE (Check Applicable Box): Residential Municipal/Public Industrial Agricultural
 Monitoring Recovery Heat Pump Water Injection Other If Other, List Use private

2. WELL LOCATION:
 Nearest Town: Monzing County Avery
WEST Chestnut Ln
 (Street Name, Numbers, Community, Subdivision, Lot No., Zip Code)

Topographic/Land setting
 Ridge Slope Valley Flat
 (check appropriate box)
 Latitude/longitude of well location _____

3. Latitude/longitude source: GPS Topographic map
 (degrees/minutes/seconds) (check box)

Area code - phone number _____
 4. DATE DRILLED 9-30-03
 5. TOTAL DEPTH: 420
 6. DOES WELL REPLACE EXISTING WELL? YES NO
 7. STATIC WATER LEVEL Below Top of Casing: 60 FT.
 (Use "+" if Above Top of Casing)
 8. TOP OF CASING IS 1 FT. Above Land Surface*
 *Top of casing terminated at/or below land surface requires a variance in accordance with 15A NCAC 2C .0118.
 9. YIELD (gpm): 20 METHOD OF TEST Ric
 10. WATER ZONES (depth): 60-67 gal
357-360 19901

DEPTH		DRILLING LOG
From	To	Formation Description
<u>0</u>	<u>40</u>	<u>red dirt</u>
<u>40</u>	<u>60</u>	<u>granite</u>
<u>60</u>	<u>67</u>	<u>shale</u>
<u>67</u>	<u>357</u>	<u>granite</u>
<u>357</u>	<u>360</u>	<u>orenes</u>
<u>360</u>	<u>420</u>	<u>granite</u>

11. DISINFECTION: Type HTH Amount 30%
 12. CASING: Wall Thickness _____

From	Depth	To	Diameter	or Weight/Ft.	Material
<u>-1</u>	<u>40</u>	<u>40</u>	<u>6 1/2</u>	<u>50R21</u>	<u>PVC</u>
From _____	To _____	Ft. _____	_____	_____	_____
From _____	To _____	Ft. _____	_____	_____	_____


From	Depth	To	Material	Method
<u>0</u>	<u>20</u>	<u>20</u>	<u>ccant</u>	<u>packed</u>
From _____	To _____	Ft. _____	_____	_____
From _____	To _____	Ft. _____	_____	_____

From	Depth	To	Diameter	Slot Size	Material
From _____	To _____	Ft. _____	_____	_____	_____
From _____	To _____	Ft. _____	_____	_____	_____

From	Depth	To	Size	Material
From _____	To _____	Ft. _____	_____	_____
From _____	To _____	Ft. _____	_____	_____

LOCATION SKETCH


Show direction and distance in miles from at least two State Roads or County Roads. Include the road numbers and common road names.

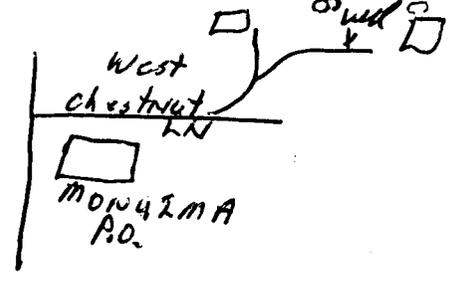

RECEIVED/DEHR/DWD
ADUIFER PROTECTION SEC

16. REMARKS: _____

I DO HEREBY CERTIFY THAT THIS WELL WAS CONSTRUCTED IN ACCORDANCE WITH 15A NCAC 2C, WELL CONSTRUCTION STANDARDS. AND THAT A COPY OF THIS RECORD HAS BEEN PROVIDED TO THE WELL OWNER

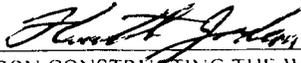
 SIGNATURE OF PERSON CONSTRUCTING THE WELL

9-30-03
 DATE