

app

303059

WELL CONSTRUCTION RECORD

North Carolina - Department of Environment and Natural Resources - Division of Water Quality - Groundwater Section

WELL CONTRACTOR (INDIVIDUAL) NAME (print) Kenneth Jordan CERTIFICATION # 2669

WELL CONTRACTOR COMPANY NAME Braswell Well Drilling PHONE # ()

STATE WELL CONSTRUCTION PERMIT# _____ ASSOCIATED WQ PERMIT# _____
(if applicable) (if applicable)

1. WELL USE (Check Applicable Box): Residential Municipal/Public Industrial Agricultural
Monitoring Recovery Heat Pump Water Injection Other If Other, List Use private

2. WELL LOCATION:
Nearest Town: Pineville County Avery
245 Pritchard Rd.
(Street Name, Numbers, Community, Subdivision, Lot No., Zip Code)

Topographic/Land setting
 Ridge Slope Valley Flat
(check appropriate box)
Latitude/longitude of well location

3. _____
(degrees/minutes/seconds)
Latitude/longitude source: GPS Topographic map
(check box)

Area code- Phone number
4. DATE DRILLED 10-7-03
5. TOTAL DEPTH: 360

DEPTH		DRILLING LOG
From	To	Formation Description
<u>0</u>	<u>55</u>	<u>red, brown dirt</u>
<u>54</u>	<u>65</u>	<u>granite</u>
<u>65</u>	<u>73</u>	<u>shale</u>
<u>73</u>	<u>360</u>	<u>granite</u>

6. DOES WELL REPLACE EXISTING WELL? YES NO
7. STATIC WATER LEVEL Below Top of Casing: 40 FT.
(Use "+" if Above Top of Casing)
8. TOP OF CASING IS 1 FT. Above Land Surface*

*Top of casing terminated at/or below land surface requires a variance in accordance with 15A NCAC 2C .0118.

9. YIELD (gpm): 1 METHOD OF TEST Run
10. WATER ZONES (depth): 65-73 gal

11. DISINFECTION: Type HTH Amount 3oz
12. CASING: _____
Wall Thickness _____

From	To	Depth	Diameter	or Weight/Ft.	Material
<u>1</u>	<u>60</u>	<u>64</u>	<u>50RPI</u>	<u>PC</u>	
From	To	Ft.			
From	To	Ft.			

13. GROUT: _____
Depth _____ Material _____ Method _____
From 0 To 80 Ft. CEMENT POURED


14. SCREEN: _____
Depth _____ Diameter _____ Slot Size _____ Material _____
From _____ To _____ Ft. _____ in. _____ in. _____

15. SAND/GRAVEL PACK: _____
Depth _____ Size _____ Material _____
From _____ To _____ Ft. _____

16. REMARKS: _____

I DO HEREBY CERTIFY THAT THIS WELL WAS CONSTRUCTED IN ACCORDANCE WITH 15A NCAC 2C, WELL CONSTRUCTION STANDARDS. AND THAT A COPY OF THIS RECORD HAS BEEN PROVIDED TO THE WELL OWNER

SIGNATURE OF PERSON CONSTRUCTING THE WELL DATE 10-9-03

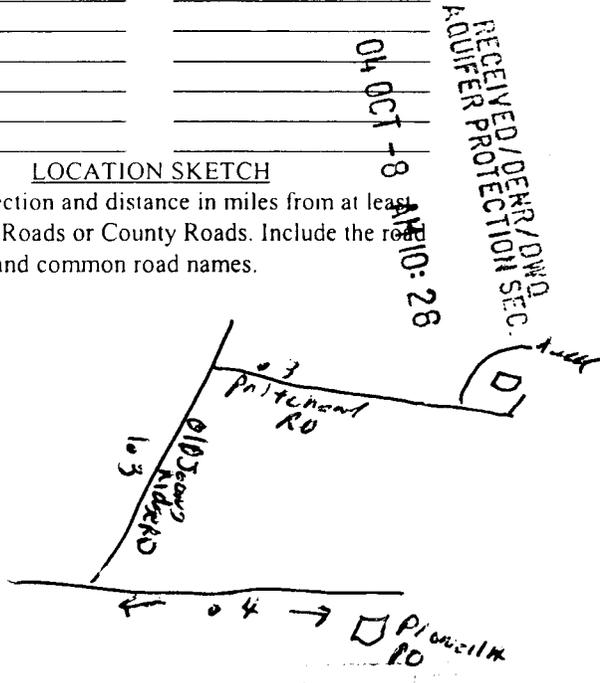

RECEIVED/DEPR/DWD
AQUIFER PROTECTION SEC.
OCT - 8 AM 10:28