

CRD

303093

WELL CONSTRUCTION RECORD

North Carolina - Department of Environment and Natural Resources - Division of Water Quality - Groundwater Section

WELL CONTRACTOR (INDIVIDUAL) NAME (print) Kevin Roberson CERTIFICATION # 2590

WELL CONTRACTOR COMPANY NAME BRASWELL Well Drilling PHONE # (919) 733-2602

STATE WELL CONSTRUCTION PERMIT# _____ ASSOCIATED WQ PERMIT# _____
(if applicable) (if applicable)

1. WELL USE (Check Applicable Box): Residential Municipal/Public Industrial Agricultural
 Monitoring Recovery Heat Pump Water Injection Other If Other, List Use _____

2. WELL LOCATION:
 Nearest Town: Plumtree County Avery
141 Gaddy Rd. off Pancake
 (Street Name, Numbers, Community, Subdivision, Lot No., Zip Code)

Topographic/Land setting
 Ridge Slope Valley Flat
 (check appropriate box)
 Latitude/longitude of well location

 (degrees/minutes/seconds)

3. Latitude/longitude source: GPS Topographic map
 (check box)

DEPTH		DRILLING LOG
From	To	Formation Description
0	68	cherty shale
68	80	red dirt
80	100	granite

- Area code - Phone number _____
4. DATE DRILLED 6-4-03
5. TOTAL DEPTH: 100 ft
6. DOES WELL REPLACE EXISTING WELL? YES NO
7. STATIC WATER LEVEL Below Top of Casing: 50 FT.
 (Use "+" if Above Top of Casing)
8. TOP OF CASING IS 1 FT. Above Land Surface*
 *Top of casing terminated at/or below land surface requires a variance in accordance with 15A NCAC 2C .0118.
9. YIELD (gpm): 50 METHOD OF TEST AIR
10. WATER ZONES (depth): 80

11. DISINFECTION: Type chlorine Amount 600

12. CASING: Wall Thickness _____

From	To	Depth	Diameter	or Weight/Ft.	Material
0	74	Ft.	6 1/4	SOR21	PVC

13. GROUT: Method _____

From	To	Depth	Material	Method
0	25	Ft.	concrete	packed


14. SCREEN: Material _____

From	To	Depth	Diameter	Slot Size	Material

15. SAND/GRAVEL PACK: Material _____

From	To	Depth	Size	Material

LOCATION SKETCH
 Show direction and distance in miles from at least two State Roads or County Roads. Include the road numbers and common road names.

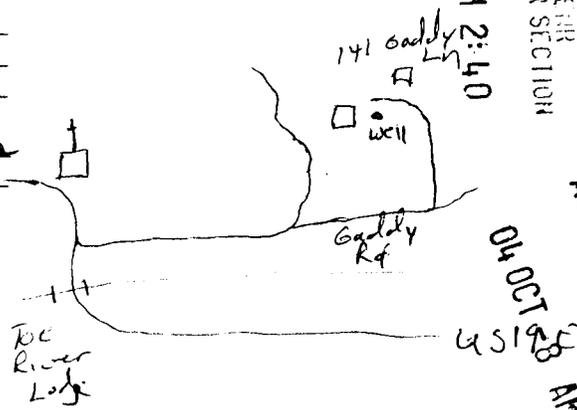

16. REMARKS: _____

I DO HEREBY CERTIFY THAT THIS WELL WAS CONSTRUCTED IN ACCORDANCE WITH 15A NCAC 2C, WELL CONSTRUCTION STANDARDS, AND THAT A COPY OF THIS RECORD HAS BEEN PROVIDED TO THE WELL OWNER

Kevin Roberson 6-4-03
 SIGNATURE OF PERSON CONSTRUCTING THE WELL DATE

03 JUL 10 PM 2:40
DWD DRILLING PER SECTION

04 OCT 05 AM 10:34
RECEIVED/DENR/DWQ/ASR/SEC
AQUIFER PROTECTION SECTION