

**WELL CONSTRUCTION RECORD**

WELL CONTRACTOR: Dewey Wright Well Pump Co., Inc.  
 WELL CONTRACTOR CERTIFICATION #: 2686  
 STATE WELL CONSTRUCTION PERMIT#: Leslie Reece

040172

1. WELL USE (Check Applicable Box): Residential  Municipal  Industrial  Agricultural  Monitoring   
 Recovery  Heat Pump Water Injection  Other  If Other, List Use: \_\_\_\_\_

2. WELL LOCATION: (Show sketch of the location below)  
 Nearest Town: BANNER ELK County: AVERY  
MEADOW AVE. LOOP OFF MEADOW AVE. OFF HICKOR  
(Road Name and Numbers, Community, or Subdivision and Lot No.)

**DRILLING LOG** **DEPTH**

From	To	Formation Description
0	41	DIRT
41	103	GRANITE
103	104	SHALE
104	340	GRANITE

3. DATE DRILLED 5/7/2004  
 4. TOTAL DEPTH 340  
 6. CUTTINGS COLLECTED YES  NO   
 7. DOES WELL REPLACE EXISTING WELL? YES  NO   
 8. STATIC WATER LEVEL Below Top of Casing: 40 FT.  
(Use "+" if Above Top of Casing)

9. TOP OF CASING IS 1 FT. Above Land Surface\*  
\*Top of casing terminated at/or below land surface requires a variance in accordance with 15A NCAC 2C.0118

10. YIELD (gpm): 1 METHOD OF TEST Air  
 11. WATER ZONES (depth): 1.00 gpm 103-104 0.00 gpm  
0.00 gpm 0.00 gpm

12. CHLORINATION: Type HTH Amount 80

13. CASING:

From	To	Depth	Diameter	Wall Thickness or Weight/Ft.	Material
0	45	Ft.	8 1/8	350	PVC
From	To	Ft.			
From	To	Ft.			

14. GROUT:

From	To	Depth	Material	Method
0	20	Ft.	Cement	Gravity Flow
From	To	Ft.		


15. SCREEN:

From	To	Depth	Diameter	Slot Size	Material
From	To	Ft.	in.	in.	
From	To	Ft.	in.	in.	
From	To	Ft.	in.	in.	

16. SAND/GRAVEL PACK:


From	To	Depth	Size	Material
From	To	Ft.		
From	To	Ft.		

17. REMARKS: \_\_\_\_\_  
 I DO HEREBY CERTIFY THAT THIS WELL WAS CONSTRUCTED IN ACCORDANCE WITH 15A NCAC 2C, WELL CONSTRUCTION STANDARDS, AND THAT A COPY OF THIS RECORD HAS BEEN PROVIDED TO THE WELL OWNER.

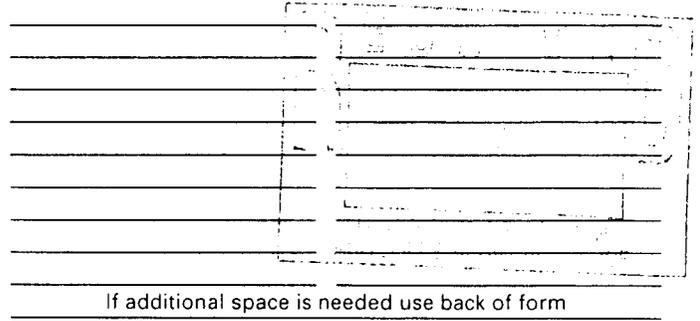

**LOCATION SKETCH**

(Show direction and distance from at least two State Roads, or other map reference points)

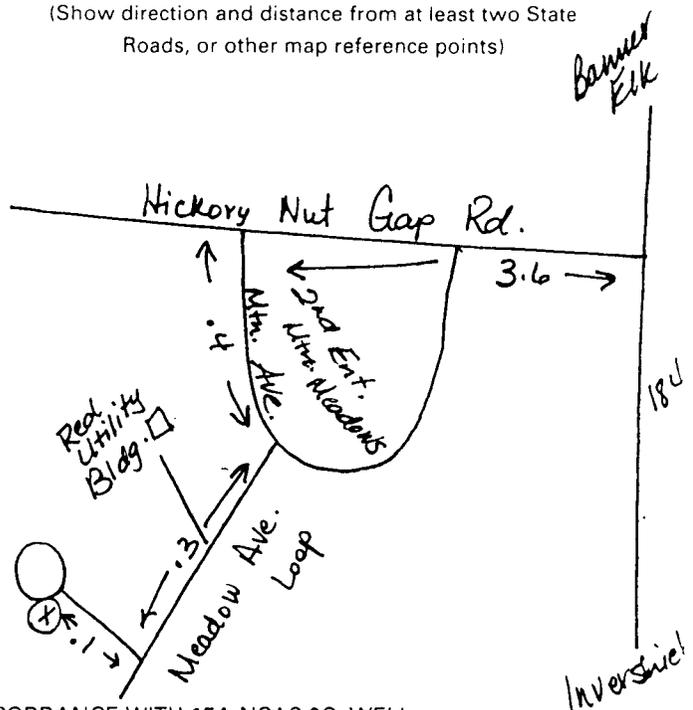

**FOR OFFICE USE ONLY**  
 Quad No: \_\_\_\_\_  
 Serial No: \_\_\_\_\_

Wayne Reece 6-3-04  
 SIGNATURE OF PERSON CONSTRUCTING THE WELL DATE  
 Submit original to Division of Water Quality, Groundwater Section within 30 days GW-1 REV. 12/99