

WELL CONSTRUCTION RECORD

WELL CONTRACTOR: Dewey Wright Well Pump Co., Inc.
 WELL CONTRACTOR CERTIFICATION #: 2886
 STATE WELL CONSTRUCTION PERMIT#: Leslie Reece

040292

1. WELL USE (Check Applicable Box): Residential Municipal Industrial Agricultural Monitoring
 Recovery Heat Pump Water Injection Other If Other, List Use: _____

2. WELL LOCATION: (Show sketch of the location below)
 Nearest Town: BANNER FLK County: AVERY
PRIVATE DR. OFF ELK RIVER RD. OFF OLD MILL RD. 0
(Road Name and Numbers, Community, or Subdivision and Lot No.)

3. DATE DRILLED 8/17/2004
 4. TOTAL DEPTH 165
 5. CUTTINGS COLLECTED YES NO
 6. DOES WELL REPLACE EXISTING WELL? YES NO
 7. STATIC WATER LEVEL Below Top of Casing: 20 FT.
(Use "+" if Above Top of Casing)

DRILLING LOG		DEPTH
From	To	Formation Description
0	18	MUD/GRAVEL
18	33	GRANITE
33	34	SHALE
34	138	GRANITE
138	139	QUARTZ
139	165	GRANITE


JUL 23 PM 12:40

If additional space is needed use back of form

9. TOP OF CASING IS 1 FT. Above Land Surface*
*Top of casing terminated at/or below land surface requires a variance in accordance with 15A NCAC 2C.0118
 10. YIELD (gpm): 8 METHOD OF TEST Air
 11. WATER ZONES (depth): 3.00 gpm 33-34 5.00 gpm 138-139
0.00 gpm 0.00 gpm
 12. CHLORINATION: Type HTH Amount 30

13. CASING:

From	To	Depth	Diameter	Wall Thickness or Weight/Ft.	Material
0	21	Ft.	6 1/4	.188	GALV.
From	To	Ft.			
From	To	Ft.			

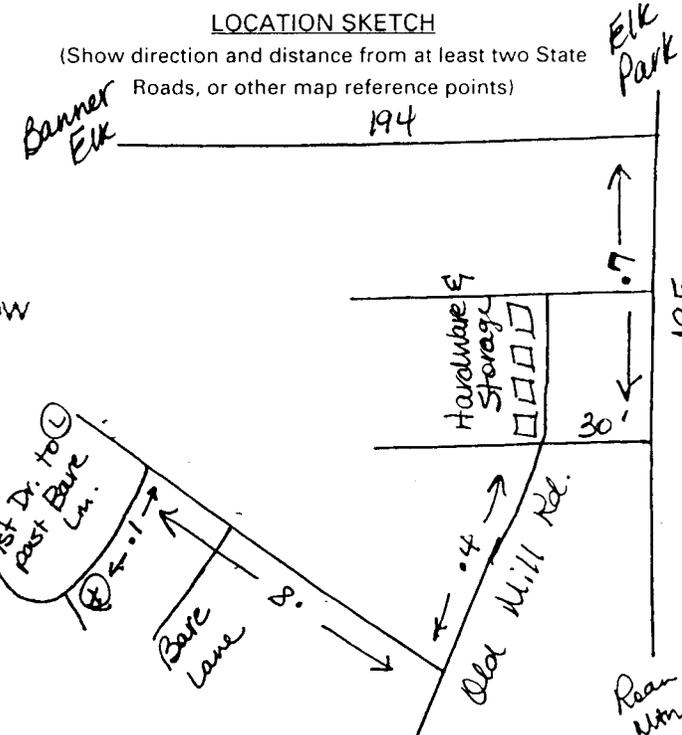

14. GROUT:

From	To	Depth	Material	Method
0	20	Ft.	Cement	Gravity Flow
From	To	Ft.	CEMENT	GRAVITY FLOW

15. SCREEN:

From	To	Depth	Diameter	Slot Size	Material
From	To	Ft.	in.	in.	
From	To	Ft.	in.	in.	
From	To	Ft.	in.	in.	

16. SAND/GRAVEL PACK:

From	To	Depth	Size	Material
From	To	Ft.		
From	To	Ft.		

17. REMARKS: _____
 I DO HEREBY CERTIFY THAT THIS WELL WAS CONSTRUCTED IN ACCORDANCE WITH 15A NCAC 2C, WELL CONSTRUCTION STANDARDS, AND THAT A COPY OF THIS RECORD HAS BEEN PROVIDED TO THE WELL OWNER.

FOR OFFICE USE ONLY
 Quad No: _____
 Serial No _____

Wayne Reece 7-20-04
 SIGNATURE OF PERSON CONSTRUCTING THE WELL DATE
 Submit original to Division of Water Quality, Groundwater Section within 30 days
 GW-1 REV. 12/99