

302196

WELL CONSTRUCTION RECORD

WELL CONTRACTOR: Dewey Wright Well Pump Co., Inc.
 WELL CONTRACTOR CERTIFICATION #: 2681
 STATE WELL CONSTRUCTION PERMIT#: Steve Petty

040430

1. WELL USE (Check Applicable Box): Residential Municipal Industrial Agricultural Monitoring
 Recovery Heat Pump Water Injection Other If Other, List Use: _____

2. WELL LOCATION: (Show sketch of the location below)
 Nearest Town: BANNER ELK County: AVERY
SAM ELLER RD. OFF HWY 184 OFF HWY 184 OFF HWY
(Road Name and Numbers, Community, or Subdivision and Lot No.)

DRILLING LOG **DEPTH**

From	To	Formation Description
0	82	DIRT
82	94	GRANITE
94	95	SHALE
95	120	GRANITE
120	121	SHALE
121	145	GRANITE

3. DATE DRILLED 8/17/2004
 4. TOTAL DEPTH 145
 5. CUTTINGS COLLECTED YES NO
 6. DOES WELL REPLACE EXISTING WELL? YES NO
 7. STATIC WATER LEVEL Below Top of Casing: 20 FT.
(Use "+" if Above Top of Casing)

9. TOP OF CASING IS 1 FT. Above Land Surface*
*Top of casing terminated at/or below land surface requires a variance in accordance with 15A NCAC 2C.0118

10. YIELD (gpm): 3 METHOD OF TEST Air
 11. WATER ZONES (depth): 1.00 gpm 94-95 2.00 gpm 120-121
0.00 gpm 0.00 gpm

12. CHLORINATION: Type HTH Amount 26


13. CASING:
 From 0 To 88 Ft. Depth 6 1/4 Diameter .188 Wall Thickness or Weight/Ft. GALV Material

14. GROUT:
 From 0 To 20 Ft. Depth Cement Material Gravity Flow Method

15. SCREEN:
 From _____ To _____ Ft. Depth _____ Diameter _____ Slot Size _____ Material _____

16. SAND/GRAVEL PACK:
 From _____ To _____ Ft. Depth _____ Size _____ Material _____

17. REMARKS: _____
 I DO HEREBY CERTIFY THAT THIS WELL WAS CONSTRUCTED IN ACCORDANCE WITH 15A NCAC 2C, WELL CONSTRUCTION STANDARDS, AND THAT A COPY OF THIS RECORD HAS BEEN PROVIDED TO THE WELL OWNER.

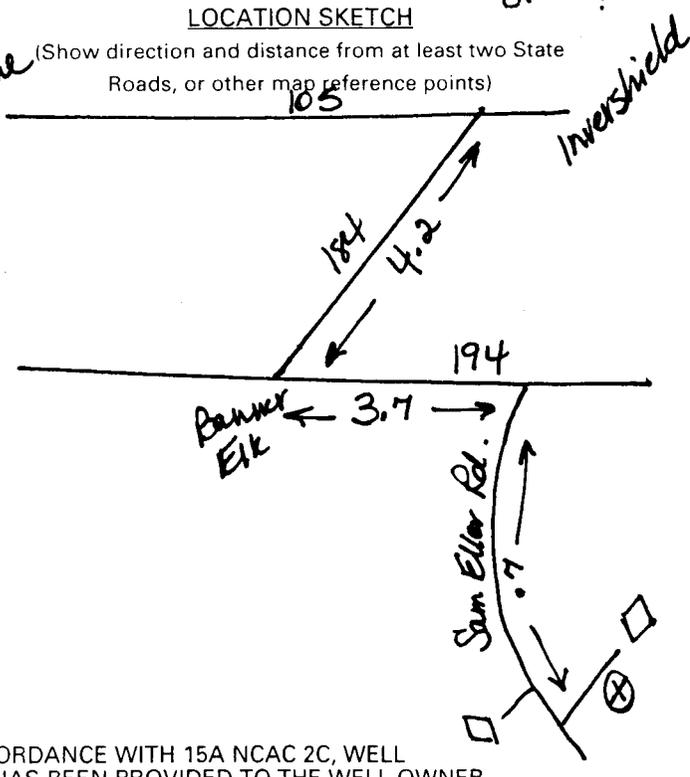

RECEIVED / DENIED / PM 9:15
 AUGUST PROTECTION DIV. SEC.
 04 SEP 24 PM 8:15

FOR OFFICE USE ONLY
 Quad No: _____
 Serial No. _____

SIGNATURE OF PERSON CONSTRUCTING THE WELL: Steve Petty DATE: 9-15-04
 Submit original to Division of Water Quality, Groundwater Section within 30 days
 GW-1 REV. 12/99