

WELL CONSTRUCTION RECORD

WELL CONTRACTOR: Dewey Wright Well Pump Co., Inc.
 WELL CONTRACTOR CERTIFICATION #: 2686
 STATE WELL CONSTRUCTION PERMIT#: Leslie Reece

040126

1. WELL USE (Check Applicable Box): Residential Municipal Industrial Agricultural Monitoring
 Recovery Heat Pump Water Injection Other If Other, List Use: _____

2. WELL LOCATION: (Show sketch of the location below)
 Nearest Town: INVERSHIELD County: AVERY
GWALTNEY RD. OFF HWY 194 OFF HWY 184 OFF HWY
(Road Name and Numbers, Community, or Subdivision and Lot No.)

3. DATE DRILLED 4/27/2004
 4. TOTAL DEPTH 125
 5. CUTTINGS COLLECTED YES NO
 6. DOES WELL REPLACE EXISTING WELL? YES NO
 7. STATIC WATER LEVEL Below Top of Casing: 10 FT.
(Use "+" if Above Top of Casing)

8. TOP OF CASING IS 1 FT. Above Land Surface*
*Top of casing terminated at/or below land surface requires a variance in accordance with 15A NCAC 2C.0118
 9. YIELD (gpm): 20 METHOD OF TEST Air
 10. WATER ZONES (depth): 0.00 gpm 10.00 gpm 77-78 0.00 gpm 111-112
 11. CHLORINATION: Type HTH Amount 23

DRILLING LOG		DEPTH
From	To	Formation Description
0	62	GRAVEL BOULDERS
62	77	GRANITE
77	78	SHALE
78	111	GRANITE
111	112	SHALE
112	125	GRANITE

RECEIVED/DEPT./DWD/SEC.
 GROUNDWATER PROTECTION DIV.
 04 SEP 24 PM 4:15


12. CASING: Type _____ Amount 23
- | From | To | Depth | Diameter | Wall Thickness or Weight/Ft. | Material |
|------|-----|-------|----------|------------------------------|----------|
| 0 | 66 | Ft. | 6 1/4 | .188 | GALV |
| 66 | 125 | Ft. | | | |

13. GROUT: Method _____
- | From | To | Depth | Material | Method |
|------|----|-------|----------|--------------|
| 0 | 20 | Ft. | Cement | Gravity Flow |

14. SCREEN: Method _____
- | From | To | Depth | Diameter | Slot Size | Material |
|------|----|-------|----------|-----------|----------|
| | | Ft. | in. | in. | |

15. SAND/GRAVEL PACK: Method _____
- | From | To | Depth | Size | Material |
|------|----|-------|------|----------|
| | | Ft. | | |

16. REMARKS: _____
 I DO HEREBY CERTIFY THAT THIS WELL WAS CONSTRUCTED IN ACCORDANCE WITH 15A NCAC 2C, WELL CONSTRUCTION STANDARDS, AND THAT A COPY OF THIS RECORD HAS BEEN PROVIDED TO THE WELL OWNER.

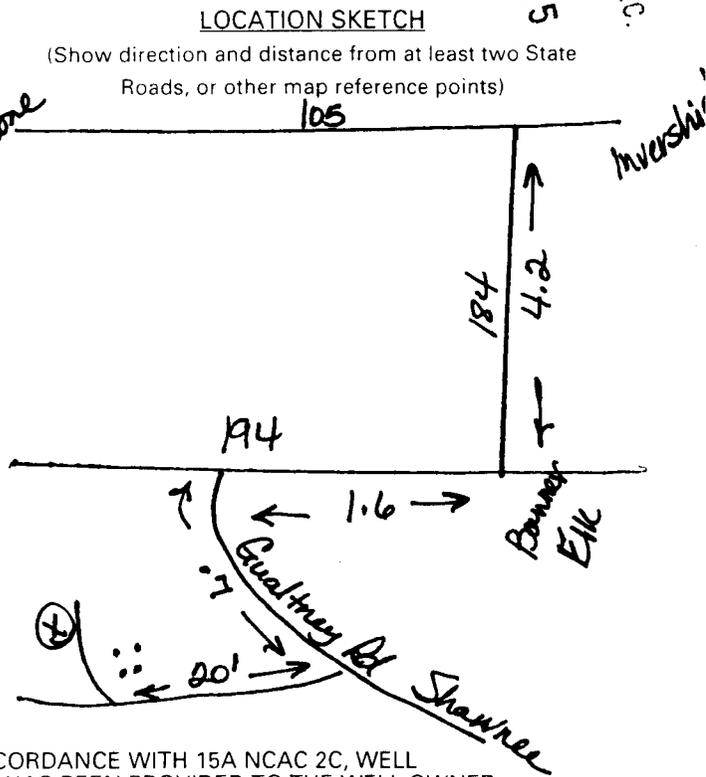

FOR OFFICE USE ONLY
 Quad No: _____
 Serial No: _____

Wayne Reece 9-16-04
 SIGNATURE OF PERSON CONSTRUCTING THE WELL DATE
 Submit original to Division of Water Quality, Groundwater Section within 30 days
 GW-1 REV. 12/99