

304181

WELL CONSTRUCTION RECORD

WELL CONTRACTOR: Dewey Wright Well Pump Co., Inc.
 WELL CONTRACTOR CERTIFICATION #: 2681
 STATE WELL CONSTRUCTION PERMIT #: Steve Petty

040419

1. WELL USE (Check Applicable Box): Residential Municipal Industrial Agricultural Monitoring
 Recovery Heat Pump Water Injection Other If Other, List Use: _____

2. WELL LOCATION: (Show sketch of the location below)
 Nearest Town: LINVILLE County: AVERY
BLOOMING WAY CIRCLE OFF ALPINE LN. OFF HWY 18
(Road Name and Numbers, Community, or Subdivision and Lot No.)

3. _____
 4. DATE DRILLED 9/15/2004
 5. TOTAL DEPTH 225
 6. CUTTINGS COLLECTED YES NO
 7. DOES WELL REPLACE EXISTING WELL? YES NO
 8. STATIC WATER LEVEL Below Top of Casing: 20 FT.
(Use "+" if Above Top of Casing)

9. TOP OF CASING IS 1 FT. Above Land Surface*
*Top of casing terminated at/or below land surface requires a variance in accordance with 15A NCAC 2C.0111
 10. YIELD (gpm): 400-40 METHOD OF TEST Air
 11. WATER ZONES (depth): 1.00 gpm 130-131 399.00 gpm 215-218
0.00 gpm 0.00 gpm
 12. CHLORINATION: Type HTH Amount 43

DRILLING LOG		DEPTH
From	To	Formation Description
0	85	DIRT
85	130	GRANITE
130	131	SHALE
131	215	GRANITE
215	218	SHALE
218	225	GRANITE

If additional space is needed use back of form


13. CASING:
 From 0 To 90 Ft. Depth 6 1/8 Diameter .350 Wall Thickness or Weight/Ft. PVC Material

14. GROUT:
 From 0 To 20 Ft. Depth Cement Material Gravity Flow Method

15. SCREEN:
 From _____ To _____ Ft. Depth _____ Diameter _____ Slot Size _____ Material _____

16. SAND/GRAVEL PACK:
 From _____ To _____ Ft. Depth _____ Size _____ Material _____

17. REMARKS: _____
 I DO HEREBY CERTIFY THAT THIS WELL WAS CONSTRUCTED IN ACCORDANCE WITH 15A NCAC 2C, WELL CONSTRUCTION STANDARDS, AND THAT A COPY OF THIS RECORD HAS BEEN PROVIDED TO THE WELL OWNER.

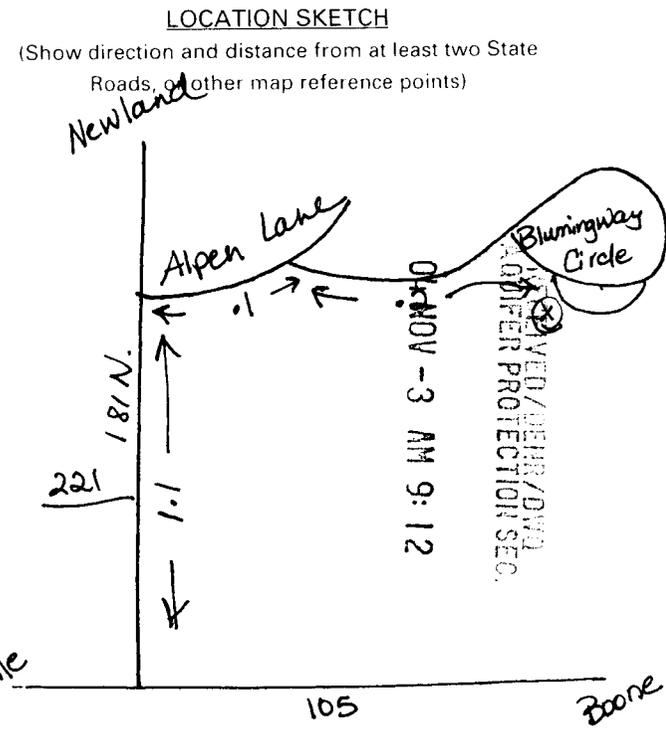

FOR OFFICE USE ONLY
 Quad No: _____

Steve Petty SIGNATURE OF PERSON CONSTRUCTING THE WELL DATE 10-20-04
 Submit original to Division of Water Quality, Groundwater Section within 30 days GW-1 REV. 12/99