

*AKI*  
 304696

# WELL CONSTRUCTION RECORD

040363

WELL CONTRACTOR: Dewey Wright Well Pump Co., Inc.  
 WELL CONTRACTOR CERTIFICATION #: 2686  
 STATE WELL CONSTRUCTION PERMIT#: Leslie Reece

1. WELL USE (Check Applicable Box): Residential  Municipal  Industrial  Agricultural  Monitoring   
 Recovery  Heat Pump Water Injection  Other  If Other, List Use: \_\_\_\_\_

2. WELL LOCATION: (Show sketch of the location below)  
 Nearest Town: NOT GROUDED PILE County: AVERY  
PRIVATE DR. OFF HWY 19E OFF HWY 194  
(Road Name and Numbers, Community, or Subdivision and Lot No.)

DRILLING LOG		DEPTH
From	To	Formation Description
0	40	MUD/GRAVEL
40	53	GRANITE
53	54	SHALE
54	96	GRANITE
96	97	SHALE
97	125	GRANITE


4. DATE DRILLED 7/19/2004  
 5. TOTAL DEPTH 125  
 6. CUTTINGS COLLECTED YES  NO   
 7. DOES WELL REPLACE EXISTING WELL? YES  NO   
 8. STATIC WATER LEVEL Below Top of Casing: 20 FT.  
(Use "+" if Above Top of Casing)  
 9. TOP OF CASING IS 1 FT. Above Land Surface\*  
\*Top of casing terminated at/or below land surface requires a variance in accordance with 15A NCAC 2C.0118  
 10. YIELD (gpm): 30 METHOD OF TEST Air  
10.00 gpm 53-54 20.00 gpm 96-97  
 11. WATER ZONES (depth): 0.00 gpm 0.00 gpm  
 12. CHLORINATION: Type HTH Amount 22

If additional space is needed use back of form

13. CASING:

From	Depth	To	Diameter	Wall Thickness or Weight/Ft.	Material
0		42	8 1/4	.188	GALV.
From		To			
From		To			

LOCATION SKETCH  
 (Show direction and distance from at least two State Roads, or other map reference points)

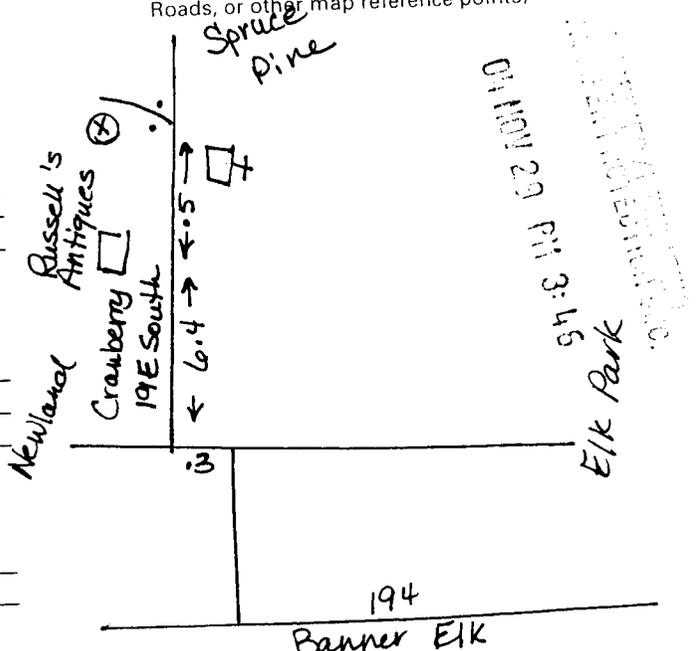

14. GROUT:

From	Depth	To	Material	Method
0		20	Cement	Gravity Flow
From		To		
From		To		

15. SCREEN:

From	Depth	To	Diameter	Slot Size	Material
From		To			
From		To			
From		To			

16. SAND/GRAVEL PACK:

From	Depth	To	Size	Material
From		To		
From		To		

17. REMARKS: I DO HEREBY CERTIFY THAT THIS WELL WAS CONSTRUCTED IN ACCORDANCE WITH 15A NCAC 2C, WELL CONSTRUCTION STANDARDS, AND THAT A COPY OF THIS RECORD HAS BEEN PROVIDED TO THE WELL OWNER.

Wayne Reece  
 SIGNATURE OF PERSON CONSTRUCTING THE WELL  
 Submit original to Division of Water Quality, Groundwater Section within 30 days  
 DATE 11-23-04  
 GW-1 REV. 12/99

FOR OFFICE USE ONLY  
 Quad No: \_\_\_\_\_