

AR

306381

WELL CONSTRUCTION RECORD

WELL CONTRACTOR: Dewey Wright Well Pump Co., Inc.
 WELL CONTRACTOR CERTIFICATION #: 2887
 STATE WELL CONSTRUCTION PERMIT#: Steve Reece

040628

1. WELL USE (Check Applicable Box): Residential Municipal Industrial Agricultural Monitoring
 Recovery Heat Pump Water Injection Other If Other, List Use: _____

2. WELL LOCATION: (Show sketch of the location below)
 Nearest Town: BANNER ELK County: AVERY
PILOT RIDGE RD. OFF 221 OFF HOLLOWAY MTN. RD. 0
(Road Name and Numbers, Community, or Subdivision and Lot No.)

| DRILLING LOG | | DEPTH |
|--------------|-----|-----------------------|
| From | To | Formation Description |
| 0 | 44 | DIRT |
| 44 | 90 | GRANITE |
| 90 | 93 | SHALE |
| 93 | 155 | GRANITE |
| 155 | 158 | SHALE |
| 158 | 180 | GRANITE |

3. DATE DRILLED 12/30/2004
 4. TOTAL DEPTH 180
 5. CUTTINGS COLLECTED YES NO
 6. DOES WELL REPLACE EXISTING WELL? YES NO
 7. STATIC WATER LEVEL Below Top of Casing: 50 FT.
(Use "+" if Above Top of Casing)

8. TOP OF CASING IS 1 FT. Above Land Surface*
*Top of casing terminated at/or below land surface requires a variance in accordance with 15A NCAC 2C.0118
 9. YIELD (gpm): 20 METHOD OF TEST Air
 10. WATER ZONES (depth): 5.00 gpm 90-93 15.00 gpm 155-158
0.00 gpm 0.00 gpm
 11. CHLORINATION: Type HTH Amount 27
If additional space is needed use back of form

13. CASING:

| From | Depth | To | Diameter | Wall Thickness or Weight/Ft. | Material |
|------|-------|----|----------|------------------------------|----------|
| 0 | | 50 | 6 1/8 | .350 | PVC |
| From | | To | | | |
| From | | To | | | |

14. GROUT:

| From | Depth | To | Material | Method |
|------|-------|----|----------|--------------|
| 0 | | 20 | Cement | Gravity Flow |
| From | | To | | |


15. SCREEN:

| From | Depth | To | Diameter | Slot Size | Material |
|------|-------|----|----------|-----------|----------|
| | | | | | |
| | | | | | |

16. SAND/GRAVEL PACK:

| From | Depth | To | Size | Material |
|------|-------|----|------|----------|
| | | | | |
| | | | | |

17. REMARKS:
 I DO HEREBY CERTIFY THAT THIS WELL WAS CONSTRUCTED IN ACCORDANCE WITH 15A NCAC 2C, WELL CONSTRUCTION STANDARDS, AND THAT A COPY OF THIS RECORD HAS BEEN PROVIDED TO THE WELL OWNER.

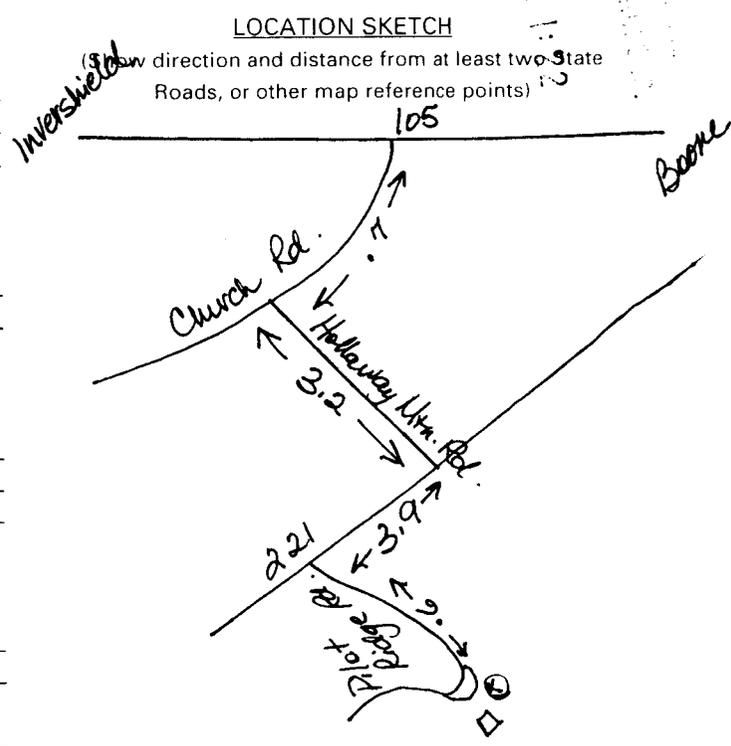

Steve Reece 1-6-05
 SIGNATURE OF PERSON CONSTRUCTING THE WELL DATE

FOR OFFICE USE ONLY
 Quad No: _____